221 9

City of Prince George
HISTORY SHEET

SHEET NUMBER **5378** **Roll Number**

Legal: LOT'S 9 & 10 BLOCK 290 D.L. 343 PLAN 1268

Address: 1767 & 1771 INGLEDEW ST.

Sanitary Connection: # 1879 2635 SIZE MATERIAL INV. CONNECTED

Water Connection # 2978 SIZE 1/2" MATERIAL Cu. METER CONNECTED

Storm Connection: # SIZE MATERIAL INV. CONNECTED

Cash Receipt No's: WATER SANITARY STORM

CURB FROM PROPERTY LINE PAVEMENT WIDTH

B.C. HYDRO O.H. UNDERGROUND CONNECTION

B.C. TELEPHONE O.H. UNDERGROUND CONNECTION

INLAND GAS AS SHOWN

Information Sheets:

Comments:
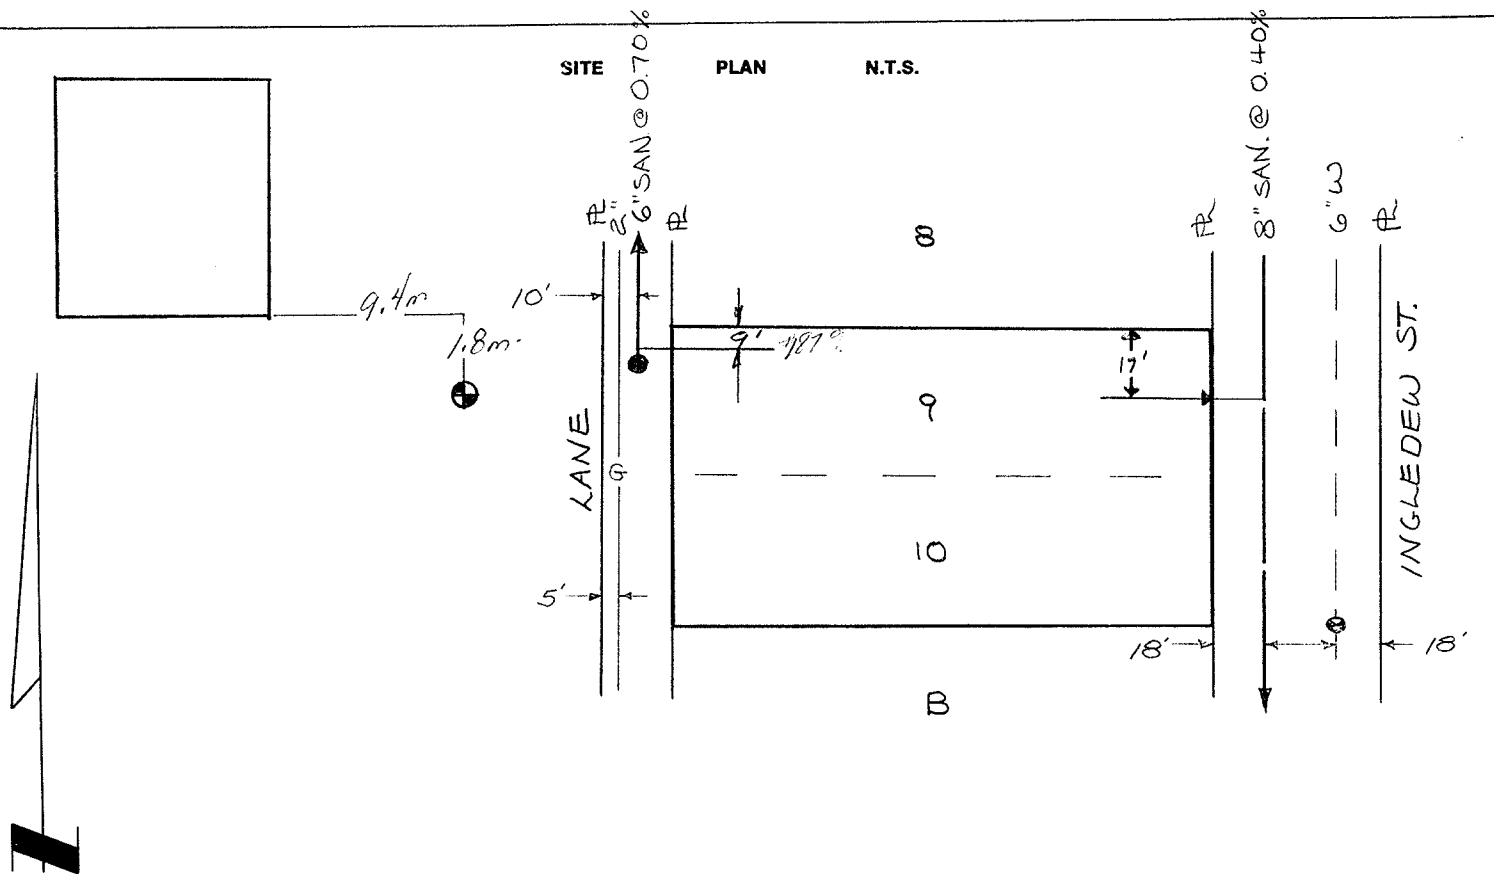
SITE PLAN N.T.S.