01183042
01186209 S

City of Prince George
HISTORY SHEET

SHEET NUMBER **5312** **Roll Number**

Legal: LOT'S B & D BLOCK 291 & 305 D.L. 343 PLAN ~~1784~~ 1268

Address: HEMLOCK ST.

Sanitary Connection: # - SIZE MATERIAL INV. CONNECTED

Water Connection # - SIZE MATERIAL METER CONNECTED

Storm Connection: # SIZE MATERIAL INV. CONNECTED

Cash Receipt No's: WATER SANITARY STORM

CURB FROM PROPERTY LINE PAVEMENT WIDTH

B.C. HYDRO O.H. UNDERGROUND CONNECTION

B.C. TELEPHONE O.H. UNDERGROUND CONNECTION

INLAND GAS AS SHOWN

Information Sheets:

Comments:
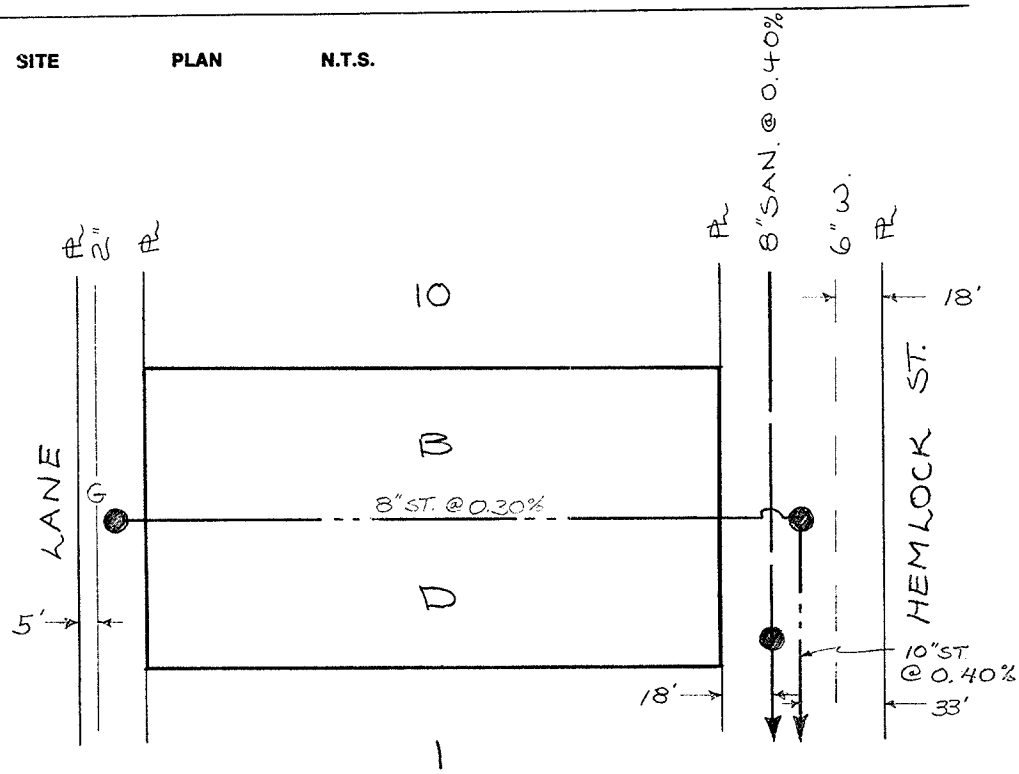
SITE PLAN N.T.S.