# City of Prince George
## HISTORY SHEET

SHEET NUMBER **Roll Number** 011847638

**Legal:** LOT'S 19 BLOCK HIGHLAND D.L. 1427 PLAN 16288

**Address:** 105 KING DRIVE

**Sanitary Connection:** # 5822 SIZE 100mm MATERIAL AC INV. 605.33 CONNECTED

**Water Connection** # 5822 SIZE 20mm MATERIAL CU METER CONNECTED

**Storm Connection:** # SIZE MATERIAL INV. CONNECTED

**Cash Receipt No's:** WATER SANITARY STORM

CURB FROM PROPERTY LINE KING DR 4.9m PAVEMENT WIDTH KING 10.4m

B.C. HYDRO AS SHOWN UNDERGROUND CONNECTION CORNER LOT

B.C. TELEPHONE AS SHOWN UNDERGROUND CONNECTION CORNER LOT

INLAND GAS 1¼" - 30mm LINE 10' - 3m from P/L.

**Information Sheets:**

**Comments:**
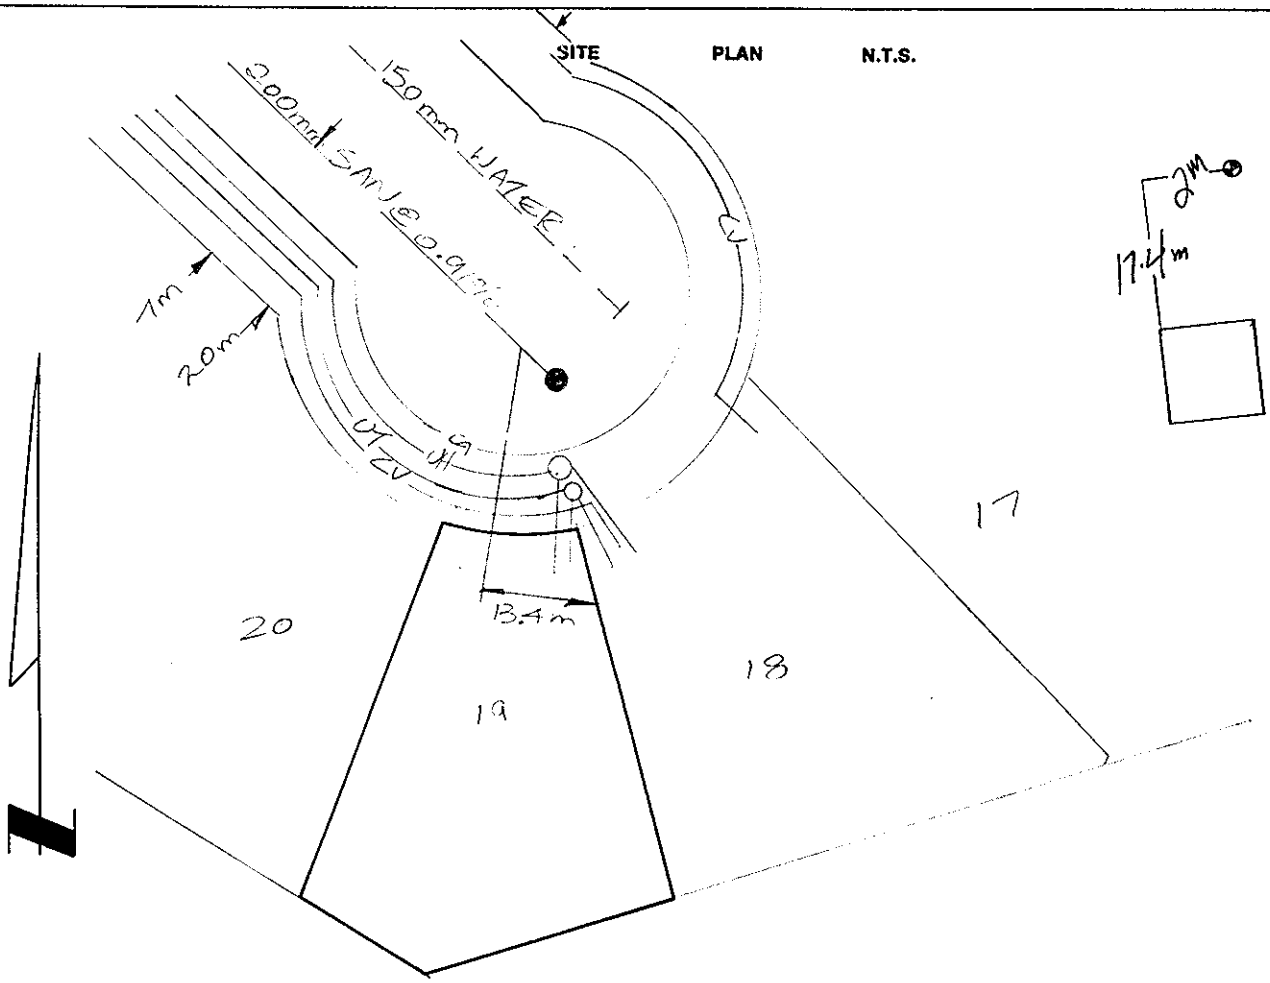
SITE PLAN N.T.S.