City of Prince George
HISTORY SHEET

SHEET NUMBER **Roll Number** 011848707

Legal: LOT'S 178 BLOCK D.L. 753 PLAN 16269

Address: 5775 OXFORD

Sanitary Connection: # SIZE MATERIAL INV. CONNECTED

Water Connection # SIZE MATERIAL METER CONNECTED

Storm Connection: # SIZE MATERIAL INV. CONNECTED

Cash Receipt No's: WATER SANITARY STORM

CURB FROM PROPERTY LINE 5.5m PAVEMENT WIDTH 10.058m

B.C. HYDRO U/G UNDERGROUND CONNECTION

B.C. TELEPHONE U/G UNDERGROUND CONNECTION

INLAND GAS ✓

Information Sheets: 3283-23

Comments:
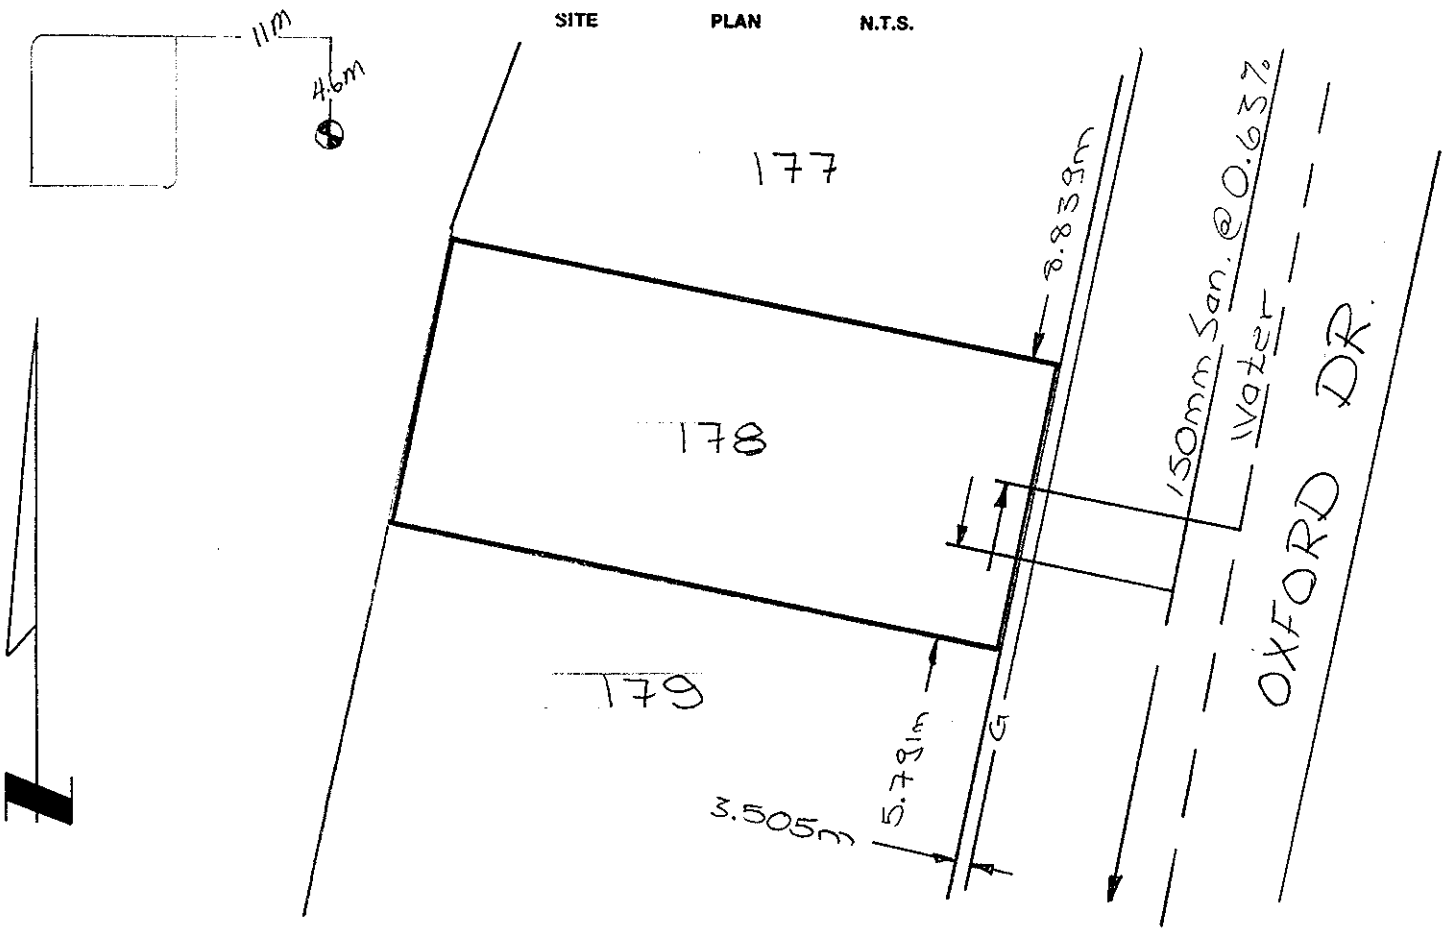
SITE PLAN N.T.S.