City of Prince George
HISTORY SHEET

SHEET NUMBER № 2974 **Roll Number**

Legal: LOT'S 3, 4 BLOCK 269 D.L. 343 PLAN 1268

Address: 1621 Connaught

Sanitary Connection: # 451 SIZE 100mm MATERIAL INV. CONNECTED

Water Connection # 484 SIZE 20mm MATERIAL ~~Copper~~ R METER CONNECTED

Storm Connection: # SIZE MATERIAL INV. CONNECTED

Cash Receipt No's: WATER SANITARY STORM

CURB FROM PROPERTY LINE 4.877m PAVEMENT WIDTH 10.363m

B.C. HYDRO UNDERGROUND CONNECTION

B.C. TELEPHONE UNDERGROUND CONNECTION

INLAND GAS

Information Sheets:

Comments:

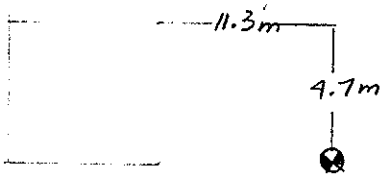
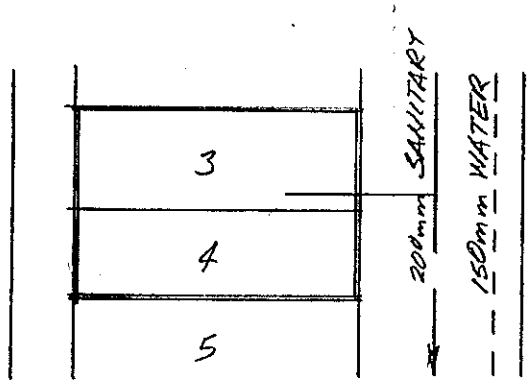
SITE PLAN N.T.S.