775
783

City of Prince George
HISTORY SHEET

SHEET NUMBER № 1836 **Roll Number**

Legal: LOT'S 10, 11, 12 BLOCK 264 D.L. 343 PLAN 1268

Address: 1323 CONNAUGHT DRIVE

Sanitary Connection: # 1466 SIZE 100mm MATERIAL INV. CONNECTED

Water Connection # SIZE MATERIAL METER CONNECTED

Storm Connection: # SIZE MATERIAL INV. CONNECTED

Cash Receipt No's: WATER SANITARY STORM

CURB FROM PROPERTY LINE PAVEMENT WIDTH

B.C. HYDRO UNDERGROUND CONNECTION

B.C. TELEPHONE UNDERGROUND CONNECTION

INLAND GAS

Information Sheets:

Comments:

10.M NORTH FROM S.W. CORNER ON P/L S c/o
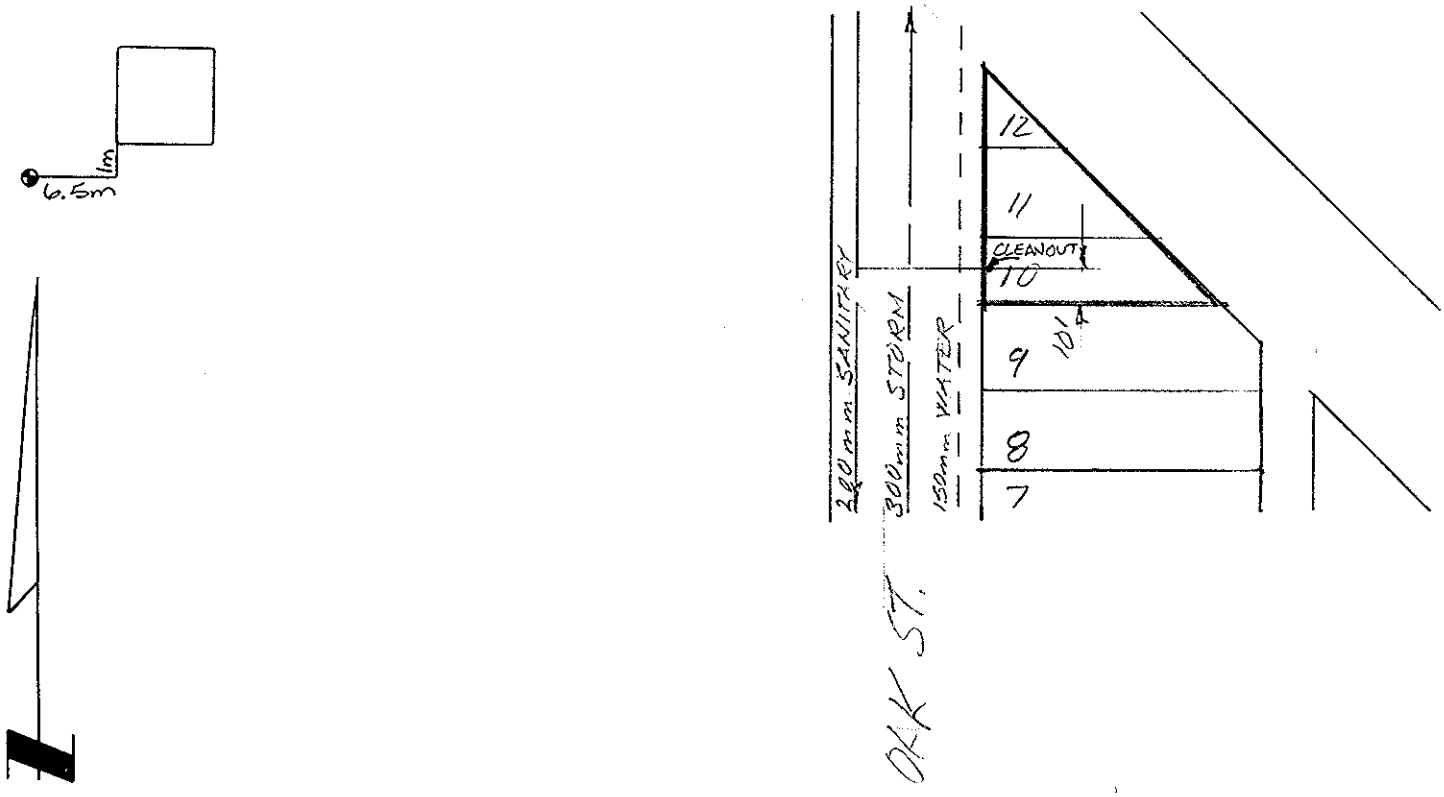
SITE PLAN N.T.S.