011872039
250

City of Prince George
HISTORY SHEET

SHEET NUMBER 5191 **Roll Number**

Legal: LOT'S 19, 20, A BLOCK 259 D.L. 343 PLAN 1268

Address: ✓1612, 1618 KENWOOD ST.

Sanitary Connection: # 3171 SIZE 100 mm MATERIAL A.C. INV. CONNECTED

Water Connection # 451 SIZE 3/4" ϕ MATERIAL Cu METER CONNECTED

Storm Connection: # SIZE MATERIAL INV. CONNECTED

Cash Receipt No's: WATER SANITARY STORM

CURB FROM PROPERTY LINE 4.877 m PAVEMENT WIDTH 10.363 m

B.C. HYDRO O/H UNDERGROUND CONNECTION

B.C. TELEPHONE O/H UNDERGROUND CONNECTION

INLAND GAS 1.524 m FROM ℞ IN LANE.

Information Sheets:

Comments:
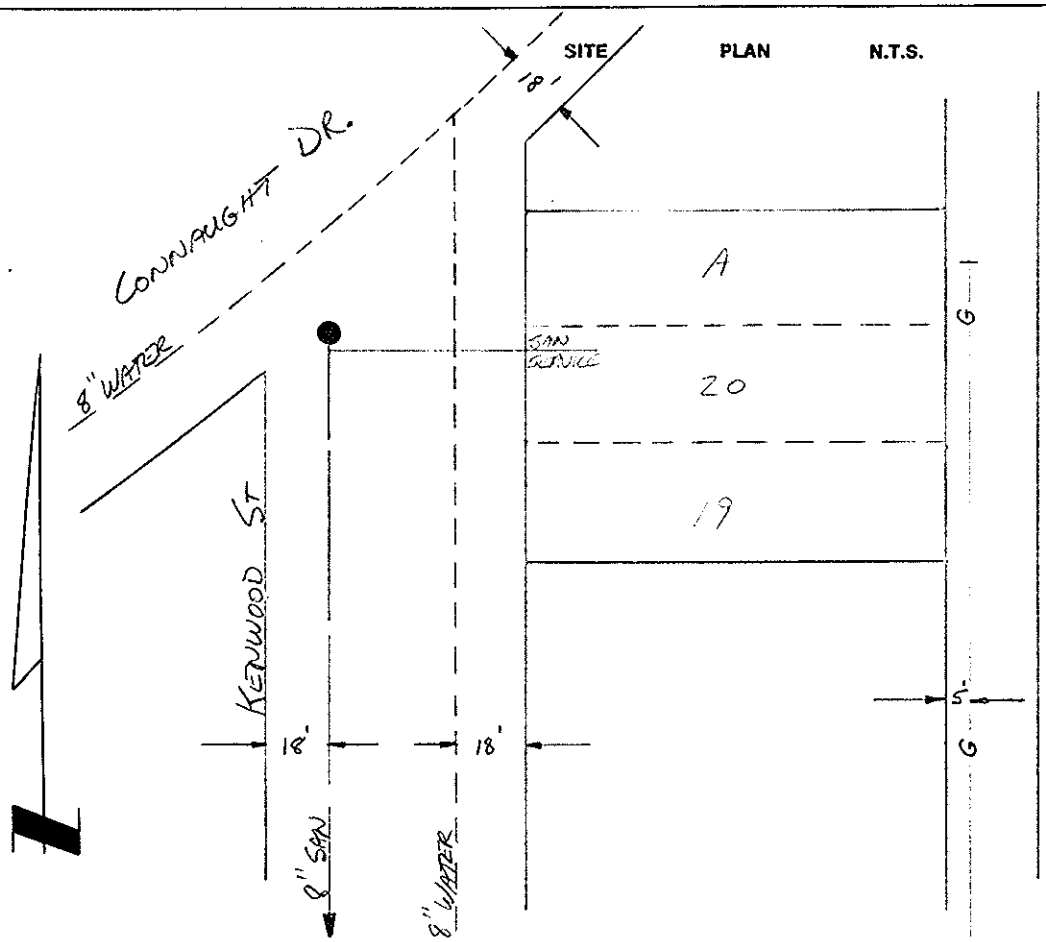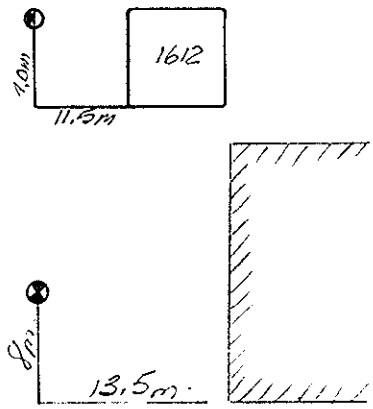
SITE PLAN N.T.S.