City of Prince George
HISTORY SHEET

SHEET NUMBER **PID #** 011 892 535

Legal: LOT'S 119 BLOCK D.L. 2507 PLAN 16 227

Address: 1341 ALEZA CRES.

Sanitary Connection: # 5277 SIZE 100 mm MATERIAL A.C. INV. 602.274 CONNECTED

Water Connection: # 5277 SIZE 20 mm MATERIAL Cu. METER CONNECTED

Storm Connection: # SIZE mm MATERIAL INV. CONNECTED

Cash Receipt No's: WATER SANITARY STORM

CURB FROM PROPERTY LINE 4.877 m PAVEMENT WIDTH 10.363 m

B.C. HYDRO U/G UNDERGROUND CONNECTION

B.C. TELEPHONE U/G UNDERGROUND CONNECTION

INLAND GAS 3.657 m FROM R.

Information Sheets:

Comments: WITH THAW WIRE.
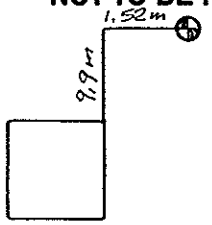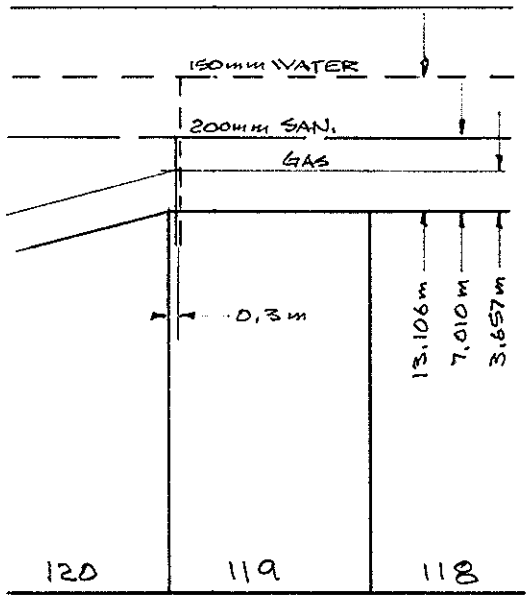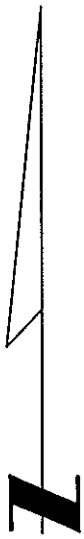
THE INFORMATION CONTAINED HEREIN IS FOR INTERNAL USE ONLY.
NOT TO BE RELIED UPON UNLESS CONFIRMED BY SITE INSPECTION AND/OR INVESTIGATION