U11 040 127
941

City of Prince George
HISTORY SHEET

SHEET NUMBER **5206** **Roll Number**

Legal: LOT'S 11 & 12 BLOCK 254 D.L. 343 PLAN 1268

Address: 610 17th AVE.

Sanitary Connection: # 2618 SIZE - MATERIAL - INV. - CONNECTED

Water Connection # 428 SIZE ½" MATERIAL Cu METER CONNECTED

Storm Connection: # SIZE MATERIAL INV. CONNECTED

Cash Receipt No's: WATER SANITARY STORM

CURB FROM PROPERTY LINE PAVEMENT WIDTH

B.C. HYDRO O.H UNDERGROUND CONNECTION

B.C. TELEPHONE O.H UNDERGROUND CONNECTION

INLAND GAS AS SHOWN

Information Sheets:
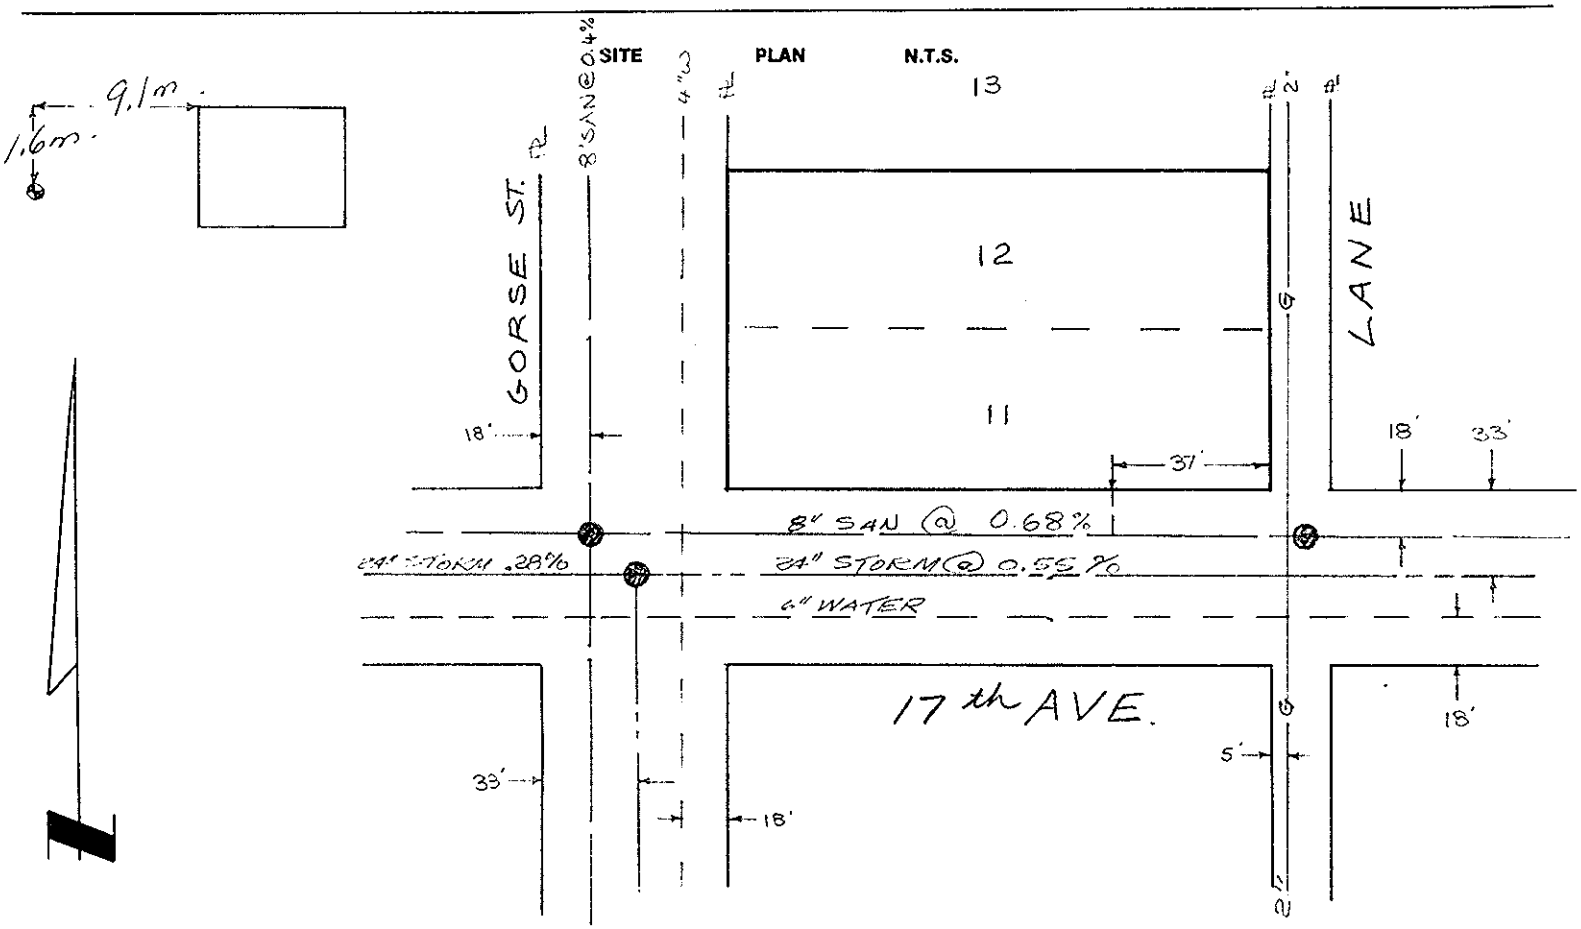
Comments: