U11 841 007
092

City of Prince George
HISTORY SHEET

SHEET NUMBER **5273** **Roll Number**

Legal: LOT'S 13 & 14 BLOCK 255 D.L. 343 PLAN 1268

Address: 1676 HEMLOCK ST.

Sanitary Connection: # 608 SIZE MATERIAL INV. 1885.88 CONNECTED

Water Connection # 2624 SIZE ½" MATERIAL Cu METER CONNECTED

Storm Connection: # SIZE MATERIAL INV. CONNECTED

Cash Receipt No's: WATER SANITARY STORM

CURB FROM PROPERTY LINE PAVEMENT WIDTH

B.C. HYDRO O.H. UNDERGROUND CONNECTION

B.C. TELEPHONE O.H. UNDERGROUND CONNECTION

INLAND GAS AS SHOWN

Information Sheets:

Comments:
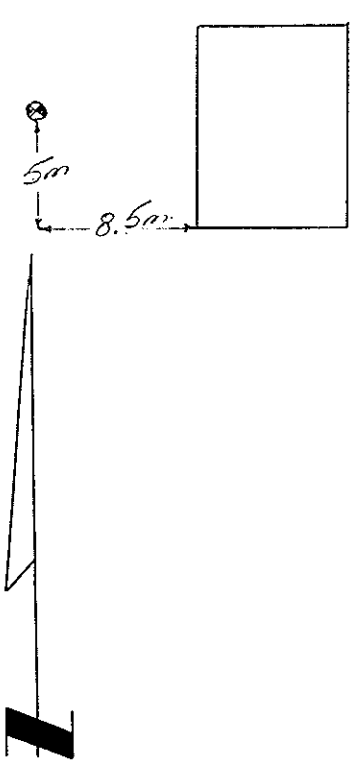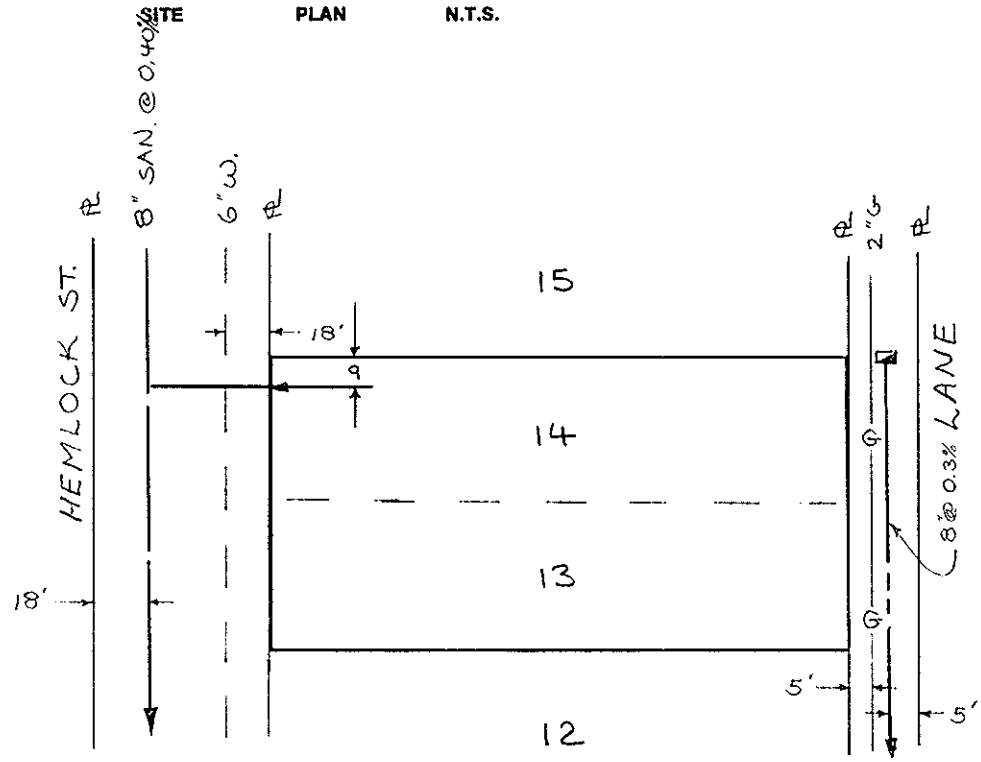
SITE PLAN N.T.S.