City of Prince George
HISTORY SHEET

SHEET NUMBER **5040** **Roll Number**

Legal: LOT'S 15 & 16 BLOCK 245 D.L. 343 PLAN 1268

Address: 1550 DOGWOOD ST.

Sanitary Connection: # SIZE MATERIAL INV. CONNECTED

Water Connection # SIZE 20mm MATERIAL Cu METER CONNECTED

Storm Connection: # SIZE MATERIAL INV. CONNECTED

Cash Receipt No's: WATER SANITARY STORM

CURB FROM PROPERTY LINE 16' PAVEMENT WIDTH 34'

B.C. HYDRO UNDERGROUND CONNECTION

B.C. TELEPHONE UNDERGROUND CONNECTION

INLAND GAS

Information Sheets:

Comments:

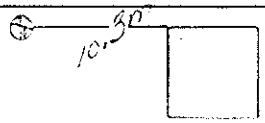
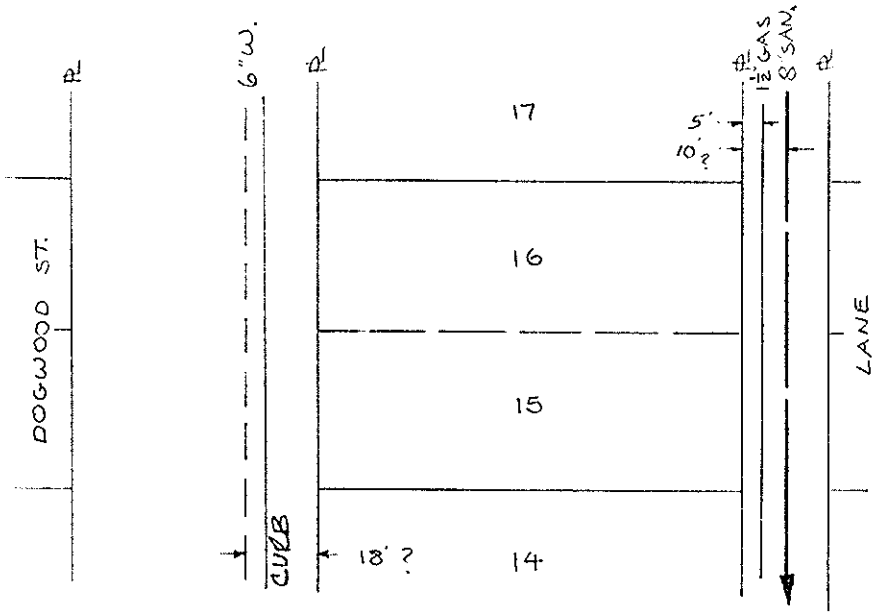
SITE PLAN N.T.S.