City of Prince George
HISTORY SHEET

SHEET NUMBER **PID #** 011904038

Legal: LOT'S 43 BLOCK D.L. 8175 PLAN 16074

Address: 2772 FAIRVIEW CRES.

Sanitary Connection: # 5947 SIZE 100 mm MATERIAL A.C. INV. 587.260 CONNECTED

Water Connection: # 5947 SIZE 20 mm MATERIAL CU. METER CONNECTED

Storm Connection: # SIZE mm MATERIAL INV. CONNECTED

Cash Receipt No's: WATER SANITARY STORM

CURB FROM PROPERTY LINE 3.962 m PAVEMENT WIDTH 10.363 m

B.C. HYDRO U/G UNDERGROUND CONNECTION

B.C. TELEPHONE U/G UNDERGROUND CONNECTION

INLAND GAS 3.352 m FROM PL IN LANE.

Information Sheets:

Comments: WITH THAW WIRE.
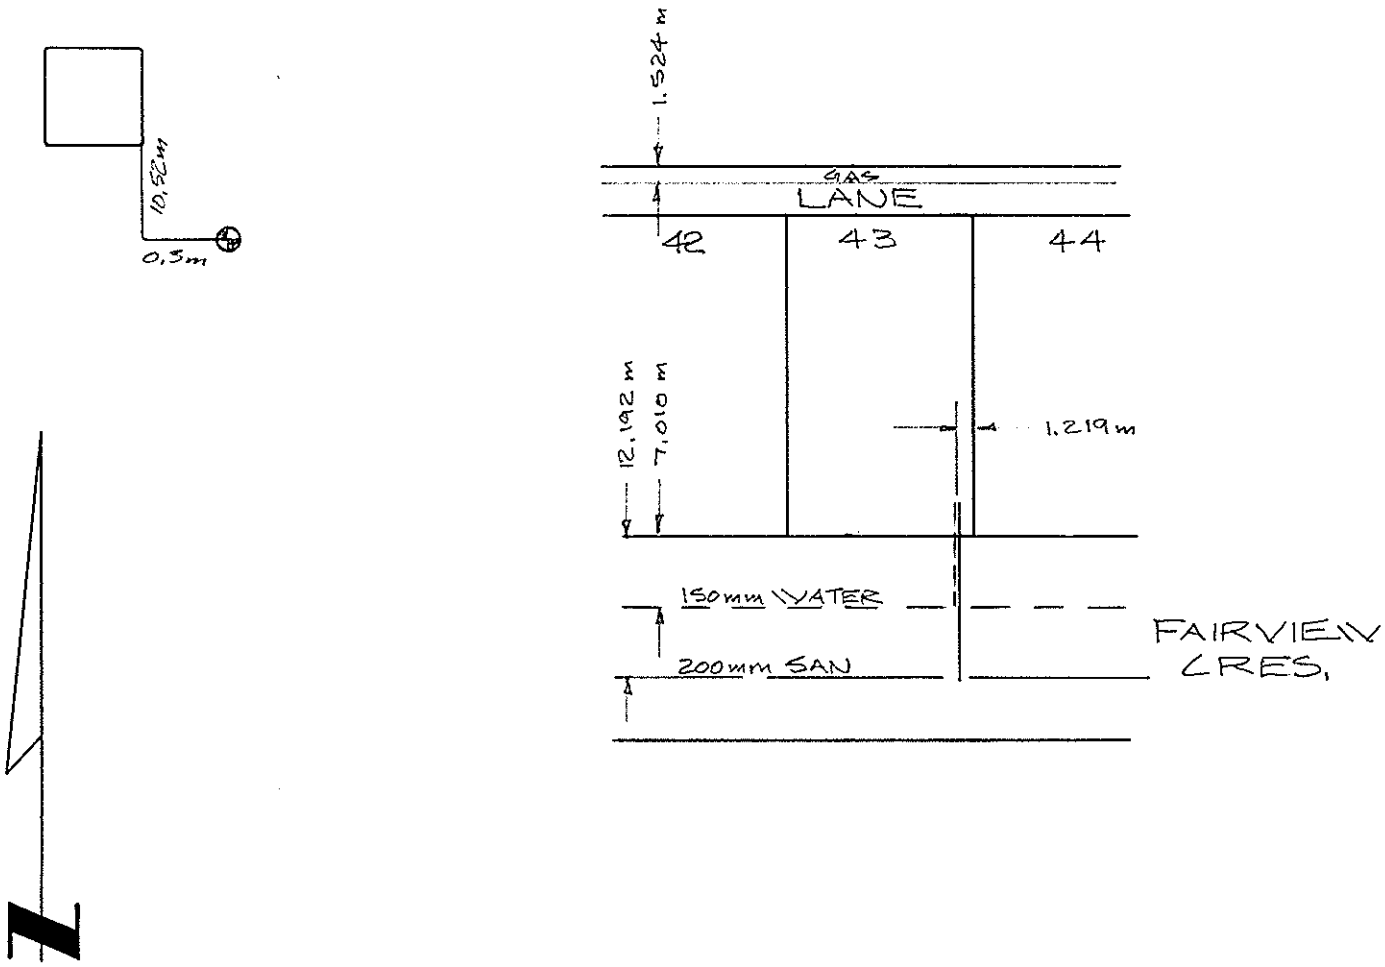
THE INFORMATION CONTAINED HEREIN IS FOR INTERNAL USE ONLY.
NOT TO BE RELIED UPON UNLESS CONFIRMED BY SITE INSPECTION AND/OR INVESTIGATION