City of Prince George
HISTORY SHEET

SHEET NUMBER **5014** **Roll Number**

Legal: LOT'S 13 - 15 BLOCK 246 D.L. 343 PLAN 1268

Address: 1556 CEDAR ST.

Sanitary Connection: # 2592 SIZE MATERIAL INV. CONNECTED

Water Connection # 401 SIZE 3/4" MATERIAL C.U. METER CONNECTED

Storm Connection: # SIZE MATERIAL INV. CONNECTED

Cash Receipt No's: WATER SANITARY STORM

CURB FROM PROPERTY LINE 16' PAVEMENT WIDTH 34'

B.C. HYDRO O.H. UNDERGROUND CONNECTION

B.C. TELEPHONE O.H. UNDERGROUND CONNECTION

INLAND GAS AS SHOWN

Information Sheets:

Comments:

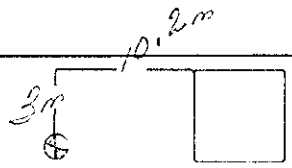
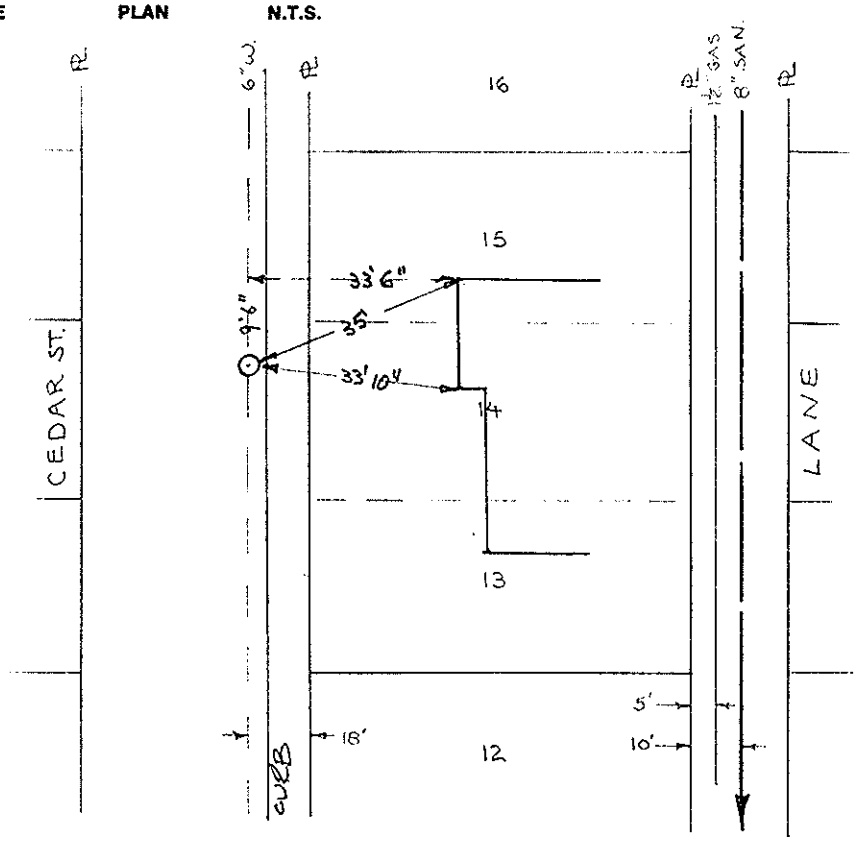
SITE PLAN N.T.S.