City of Prince George
HISTORY SHEET

SHEET NUMBER 5025 **Roll Number**

Legal: LOT'S 5 & 6 BLOCK 245 D.L. 343 PLAN 1268

Address: 1543 CEDAR ST.

Sanitary Connection: # 2584 SIZE MATERIAL INV. CONNECTED

Water Connection # 395 SIZE 1/2" ϕ MATERIAL Cu METER CONNECTED

Storm Connection: # SIZE MATERIAL INV. CONNECTED

Cash Receipt No's: WATER SANITARY STORM

CURB FROM PROPERTY LINE 16' PAVEMENT WIDTH 34'

B.C. HYDRO UNDERGROUND CONNECTION

B.C. TELEPHONE UNDERGROUND CONNECTION

INLAND GAS

Information Sheets:

Comments:
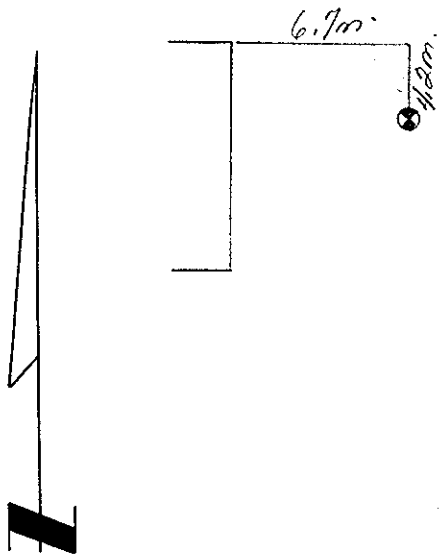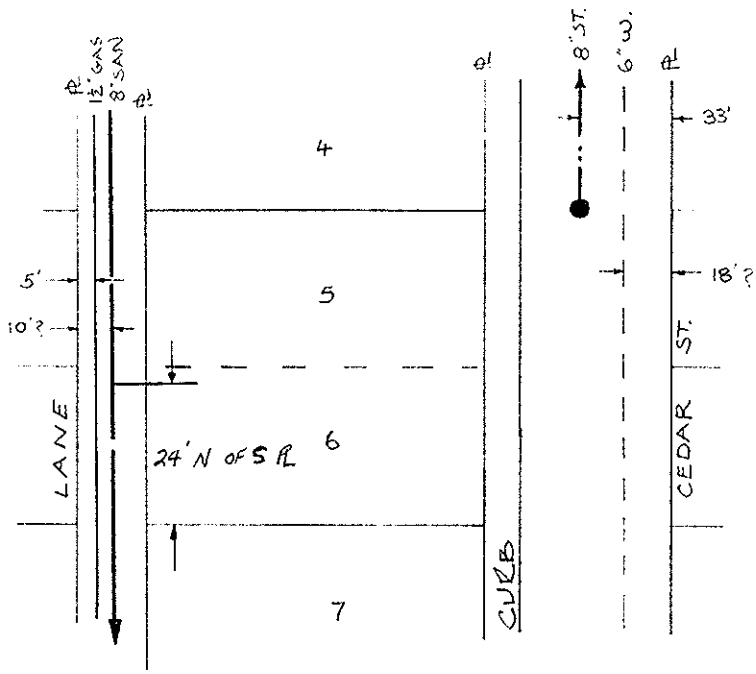
SITE PLAN N.T.S.