City of Prince George
HISTORY SHEET

SHEET NUMBER 2684 Roll Number

Legal: LOT'S 5&6 BLOCK 247 D.L. 343 PLAN 1268

Address: 1551 ASH

Sanitary Connection: # 2597 SIZE MATERIAL INV. CONNECTED

Water Connection # 403 SIZE 1/2" ϕ MATERIAL Cu METER CONNECTED

Storm Connection: # SIZE MATERIAL INV. CONNECTED

Cash Receipt No's: WATER SANITARY STORM

CURB FROM PROPERTY LINE 16' PAVEMENT WIDTH 34'

B.C. HYDRO O.H. UNDERGROUND CONNECTION

B.C. TELEPHONE O.H. UNDERGROUND CONNECTION

INLAND GAS AS SHOWN.

Information Sheets:

Comments: BM # 520-71 EL. 189.076 S/D. SE COR 15th & ASH
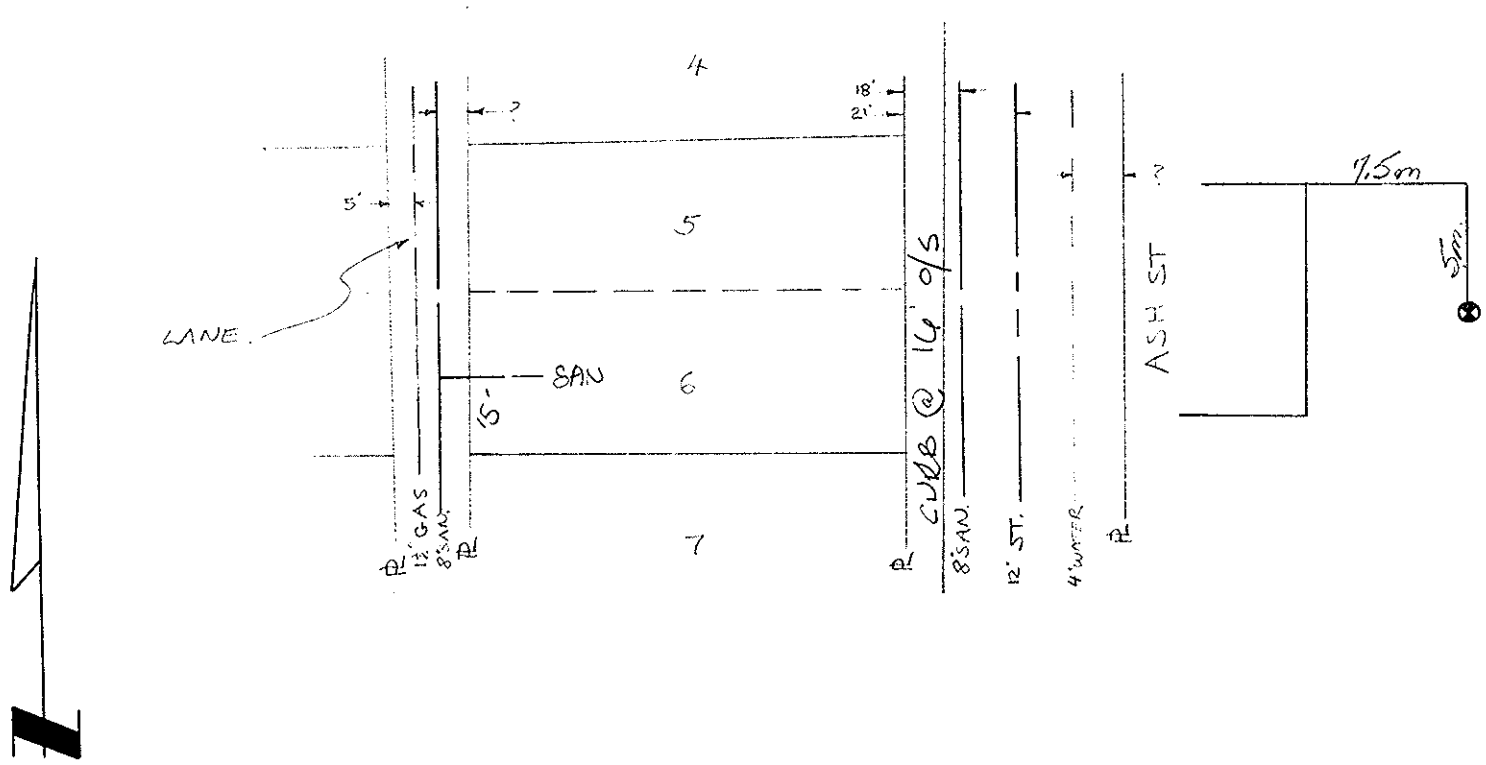
SITE PLAN N.T.S.