City of Prince George
HISTORY SHEET

SHEET NUMBER 2687 **Roll Number**

Legal: LOT'S A, 11, & 12 BLOCK 247 D.L. 343 PLAN 1268

Address: 1590 BIRCH

Sanitary Connection: # 2600 SIZE MATERIAL INV. CONNECTED

Water Connection # 2389 SIZE ½" ϕ MATERIAL Cu METER CONNECTED

Storm Connection: # SIZE MATERIAL INV. CONNECTED

Cash Receipt No's: WATER SANITARY STORM

CURB FROM PROPERTY LINE 16' PAVEMENT WIDTH 34'

B.C. HYDRO O.H. UNDERGROUND CONNECTION

B.C. TELEPHONE O.H. UNDERGROUND CONNECTION

INLAND GAS AS SHOWN

Information Sheets:

Comments:
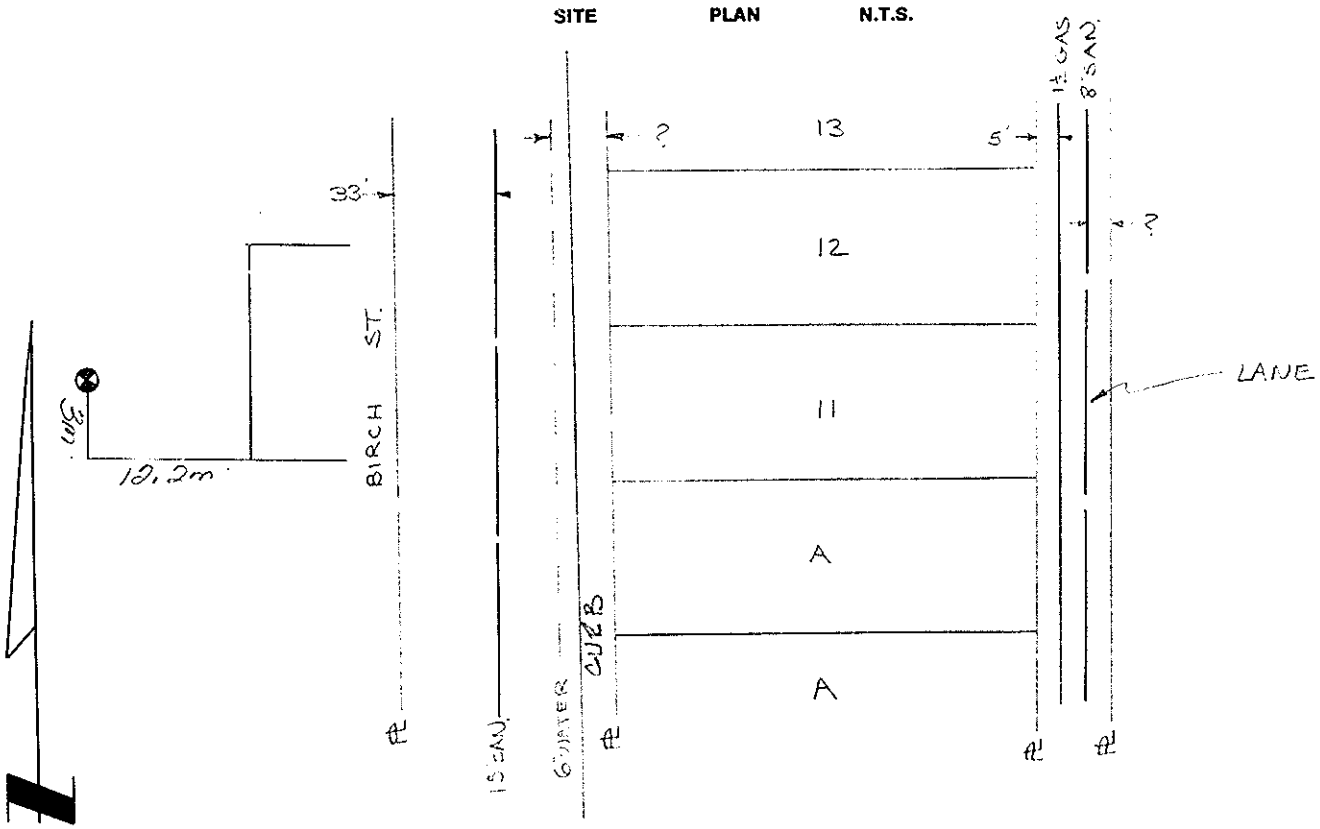
SITE PLAN N.T.S.