City of Prince George
HISTORY SHEET

SHEET NUMBER № 4228 **Roll Number** 011940336

Legal: LOT'S 114 BLOCK D.L. 1599 PLAN 15792

Address: 7721 DOW RD.

Sanitary Connection: # 12868 SIZE 4" MATERIAL INV. CONNECTED

Water Connection # SIZE 3/4" MATERIAL METER CONNECTED

Storm Connection: # SIZE MATERIAL INV. CONNECTED

Cash Receipt No's: WATER SANITARY 3019 STORM

CURB FROM PROPERTY LINE PAVEMENT WIDTH

B.C. HYDRO UNDERGROUND CONNECTION

B.C. TELEPHONE UNDERGROUND CONNECTION

INLAND GAS

Information Sheets:

Comments:
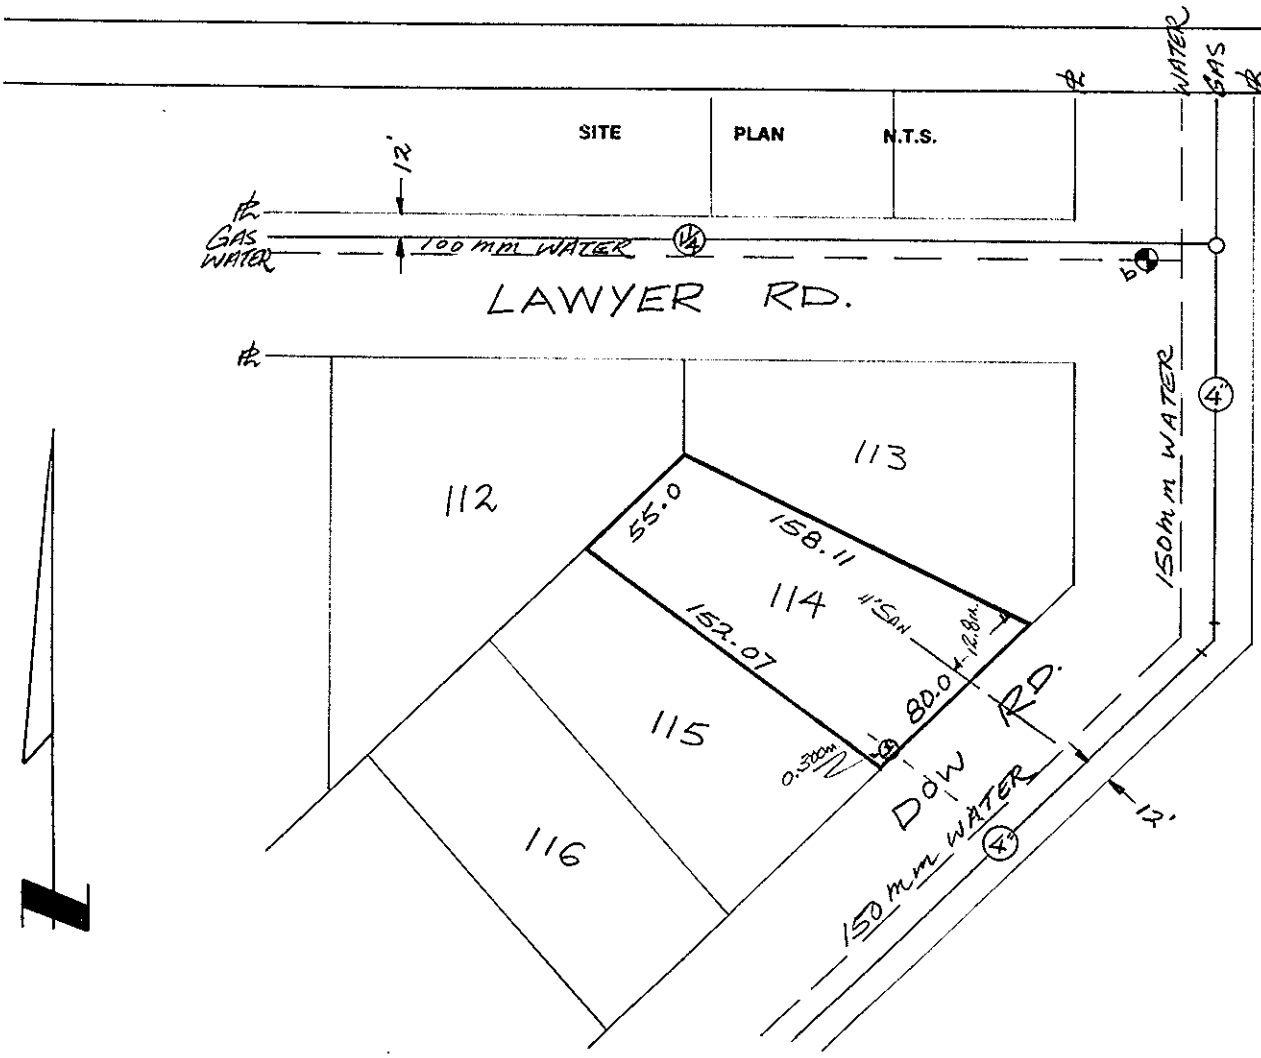
SITE PLAN N.T.S.