064

City of Prince George
HISTORY SHEET

SHEET NUMBER № 1407 **Roll Number**

Legal: LOT'S 1 - 2 BLOCK D.L. 936 PLAN 15662

Address: 3505 FIFTEENTH AVENUE (WAS 1502 NICHOLSON)

Sanitary Connection: # 375 SIZE 4" MATERIAL INV. CONNECTED

Water Connection # 4478 SIZE 2" MATERIAL Cu METER #261 CONNECTED

Storm Connection: # 225 SIZE MATERIAL INV. CONNECTED

Cash Receipt No's: WATER SANITARY 3421 STORM

CURB FROM PROPERTY LINE CURB 15' OFF P/L STREET RP's 900-901 & 932 PAVEMENT WIDTH VARIES

B.C. HYDRO UNDERGROUND CONNECTION

B.C. TELEPHONE UNDERGROUND CONNECTION

INLAND GAS 12' NORTH OF NORTH PROPERTY LINE

Information Sheets:

Comments:
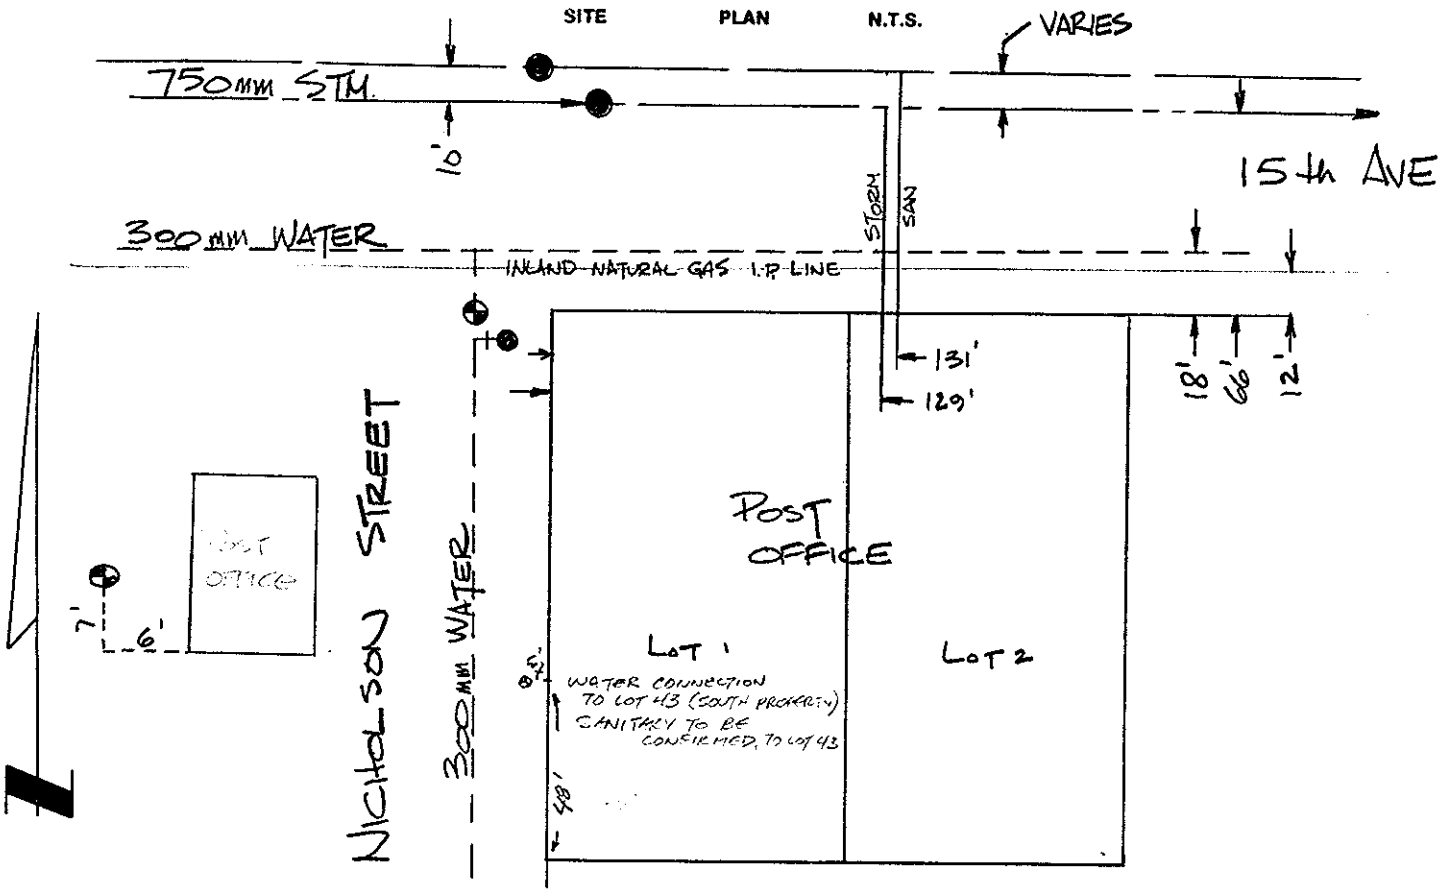
SITE PLAN N.T.S.