City of Prince George
HISTORY SHEET

011977 311

SHEET NUMBER 10420 **Roll Number**

Legal: LOT'S 32 BLOCK D.L. 2433 PLAN 15556

Address: 4119 CHESTNUT DR.

Sanitary Connection: # 15685 SIZE 100 MM MATERIAL PVC INV. CONNECTED

Water Connection # SIZE 20 MM MATERIAL Cu METER CONNECTED

Storm Connection: # SIZE MATERIAL INV. CONNECTED

Cash Receipt No's: WATER SANITARY STORM

CURB FROM PROPERTY LINE PAVEMENT WIDTH

B.C. HYDRO UNDERGROUND CONNECTION

B.C. TELEPHONE UNDERGROUND CONNECTION

INLAND GAS

Information Sheets:

Comments: N/C WATER SERVICE; S.P. IS 10" INSIDE GROUND.
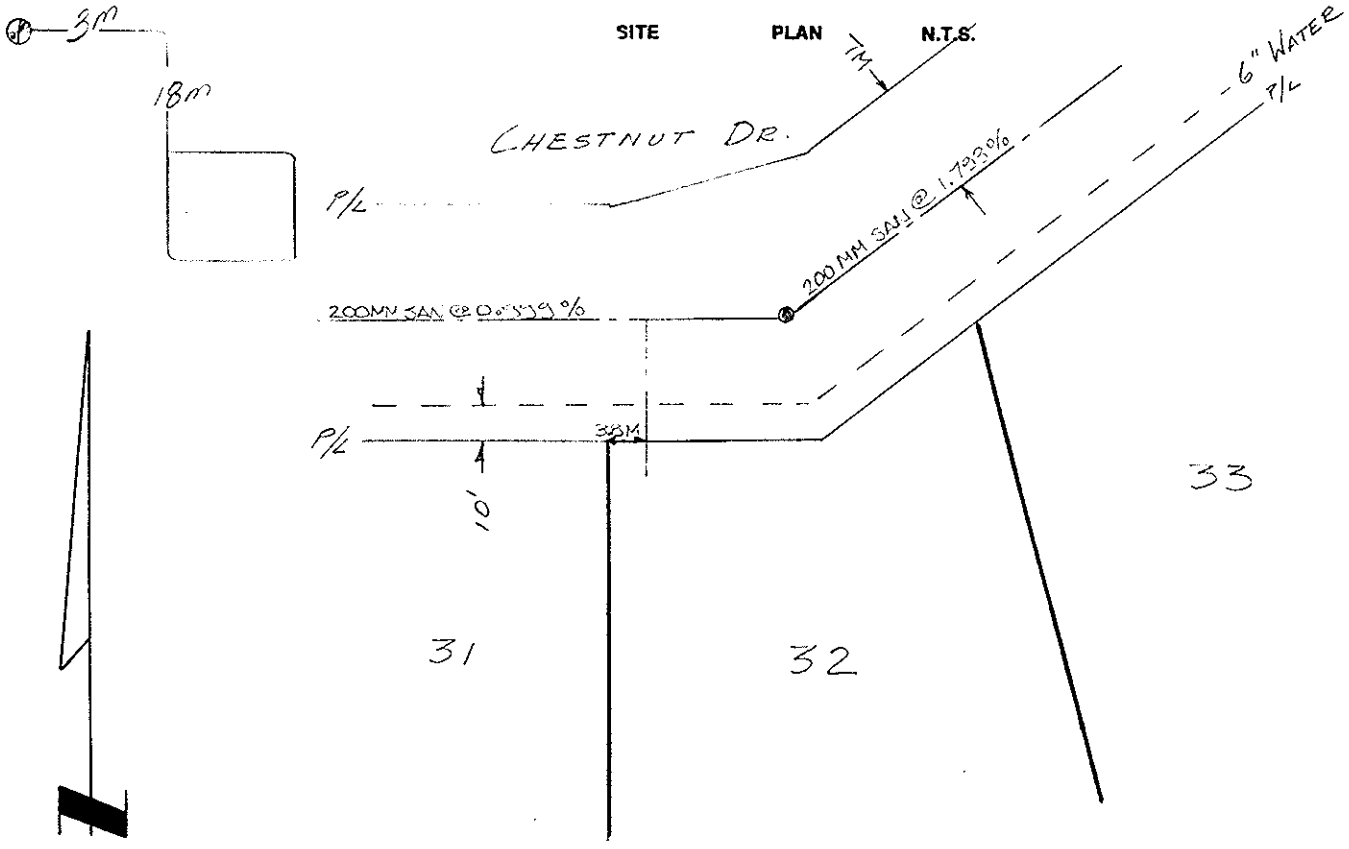
SITE PLAN N.T.S.