City of Prince George
HISTORY SHEET

SHEET NUMBER 10941 **Roll Number** 018008887

Legal: LOT'S 2 BLOCK E D.L. 4377 PLAN 15401

Address: 1885 AINTREE DR.

Sanitary Connection: # 12742 SIZE 4" MATERIAL PVC INV. CONNECTED

Water Connection # 12742 SIZE 3/4" MATERIAL COPPER METER CONNECTED

Storm Connection: # SIZE MATERIAL INV. CONNECTED

Cash Receipt No's: WATER 4947 SANITARY 4948 STORM

CURB FROM PROPERTY LINE PAVEMENT WIDTH

B.C. HYDRO UNDERGROUND CONNECTION

B.C. TELEPHONE UNDERGROUND CONNECTION

INLAND GAS

Information Sheets:

Comments: THE INFORMATION CONTAINED HEREIN IS FOR INTERNAL USE ONLY. NOT TO BE RELIED UPON UNLESS CONFIRMED BY SITE INSPECTION AND/OR INVESTIGATION.
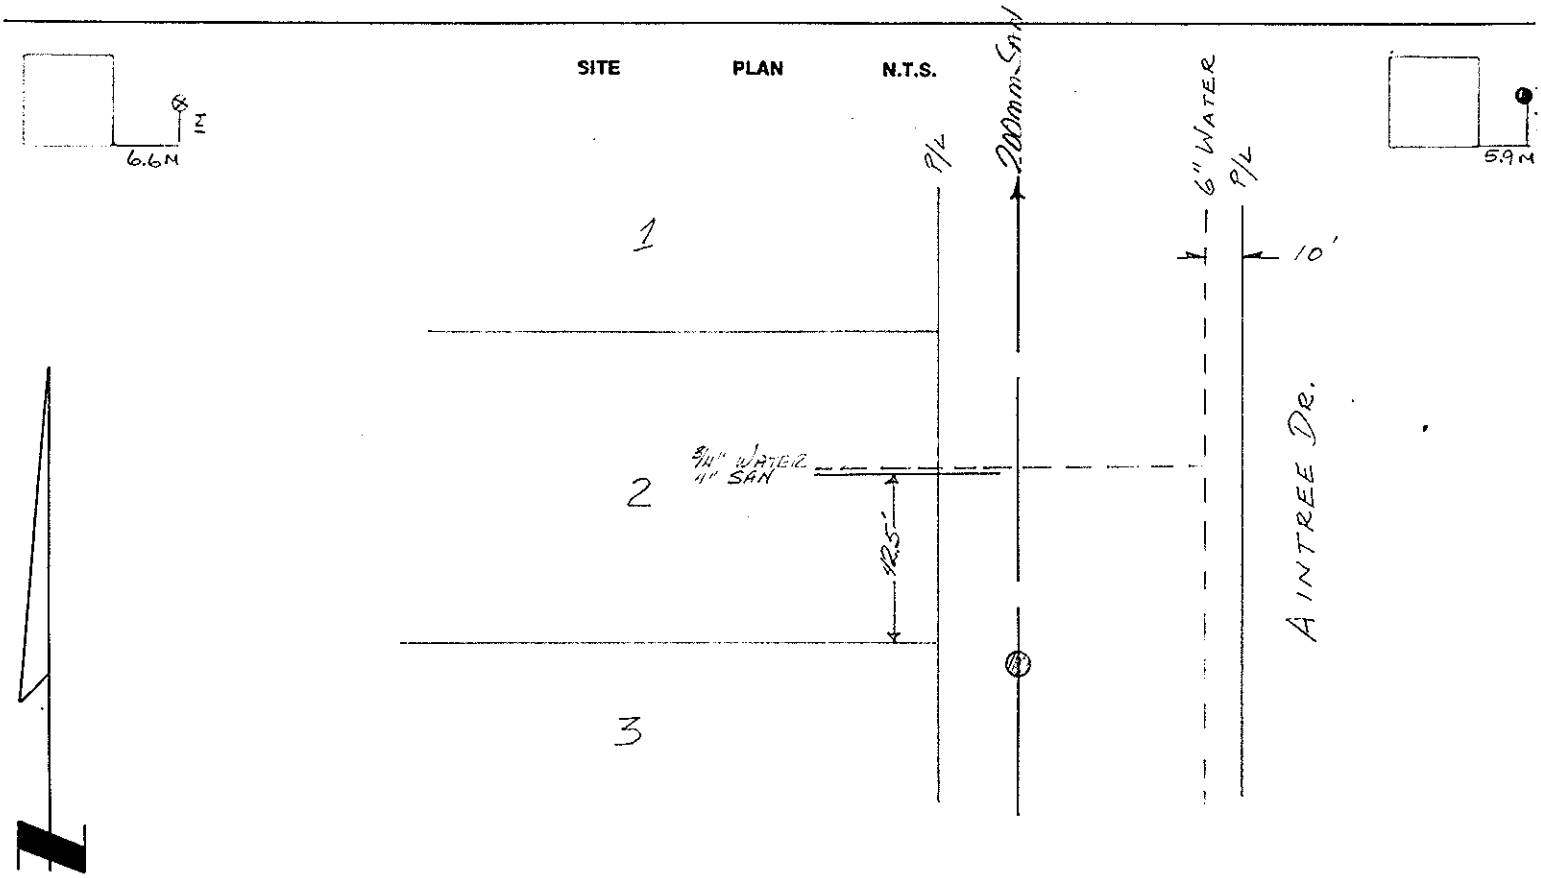
SITE PLAN N.T.S.