City of Prince George
HISTORY SHEET

SHEET NUMBER **Roll Number** 018006327

Legal: LOT'S 11 BLOCK C D.L. 4377 PLAN 15401

Address: 1117 INVERNESS RD

Sanitary Connection: # 16022 SIZE 100MM MATERIAL INV. CONNECTED

Water Connection # 16022 SIZE 20MM MATERIAL METER CONNECTED

Storm Connection: # SIZE MATERIAL INV. CONNECTED

Cash Receipt No's: WATER 1233 SANITARY 1234 STORM

CURB FROM PROPERTY LINE PAVEMENT WIDTH

B.C. HYDRO UNDERGROUND CONNECTION

B.C. TELEPHONE UNDERGROUND CONNECTION

INLAND GAS

Information Sheets:

Comments:

SITE PLAN N.T.S.

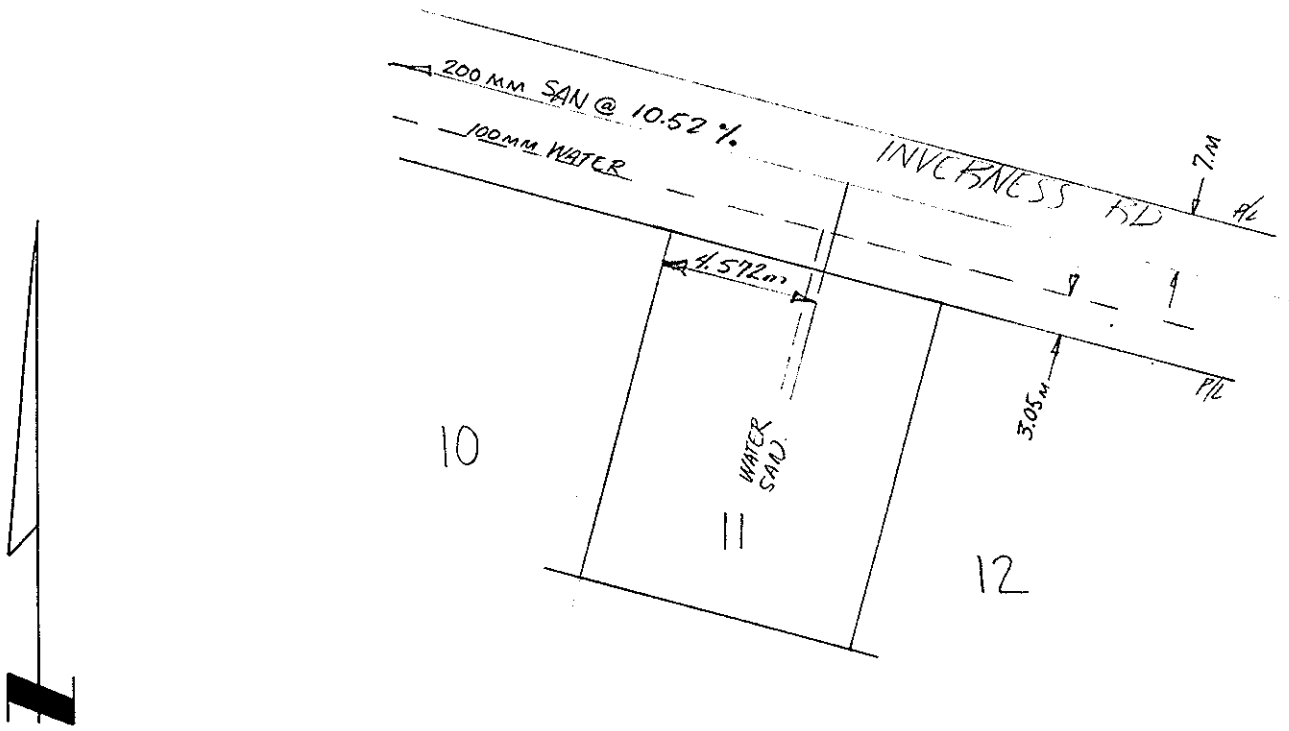

CITY OF PRINCE GEORGE

INTER OFFICE MEMO

Nº 690

RECEIVED

OCT 2[illegible]

CITY OF PRINCE GEORGE
ENGINEERING DIVISION

Date: October 22, 1982

To: Engineering Records - ATTN: A. Ali

From: Phil Taylor

Subject: Crown Land Compulsory Connections

Connection	#16019	Legal 8-C-4377-15401 1173 Inverness Rd.
"	#16020	9-C-4377-15401 1157 Inverness Rd.
"	#16021	10-C-4377-15401 1393 Inverness Rd.
"	#16022	11-C-4377-15401 1117 Inverness Rd.

Each property described above has a water and sewer connection of $1070.00 each.

These connections will not be paid for by the Province. Payment of these connections is required at the time of application for the building permit if the Crown sells these lots. When payment is made payment will include the connection fee plus interest and carrying charges from the date of connection to the date of payment calculated using the City authorized interest rate for the period covered.

The total connections on Crown Land totals $8,560.00 to be collected.

Thank You.

Phil Taylor

PAT/sw

Copy To:

Aaron Printers Ltd