City of Prince George
HISTORY SHEET

SHEET NUMBER 10966 **Roll Number** 012009814

Legal: LOT'S 14 BLOCK D D.L. 4377 PLAN 15401

Address: 1591 AINTREE PL.

Sanitary Connection: # 15166 SIZE 100mm MATERIAL INV. CONNECTED

Water Connection # SIZE 3/4" MATERIAL Copper METER CONNECTED

Storm Connection: # SIZE MATERIAL INV. CONNECTED

Cash Receipt No's: WATER 343 SANITARY STORM

CURB FROM PROPERTY LINE PAVEMENT WIDTH

B.C. HYDRO UNDERGROUND CONNECTION

B.C. TELEPHONE UNDERGROUND CONNECTION

INLAND GAS

Information Sheets:

Comments:
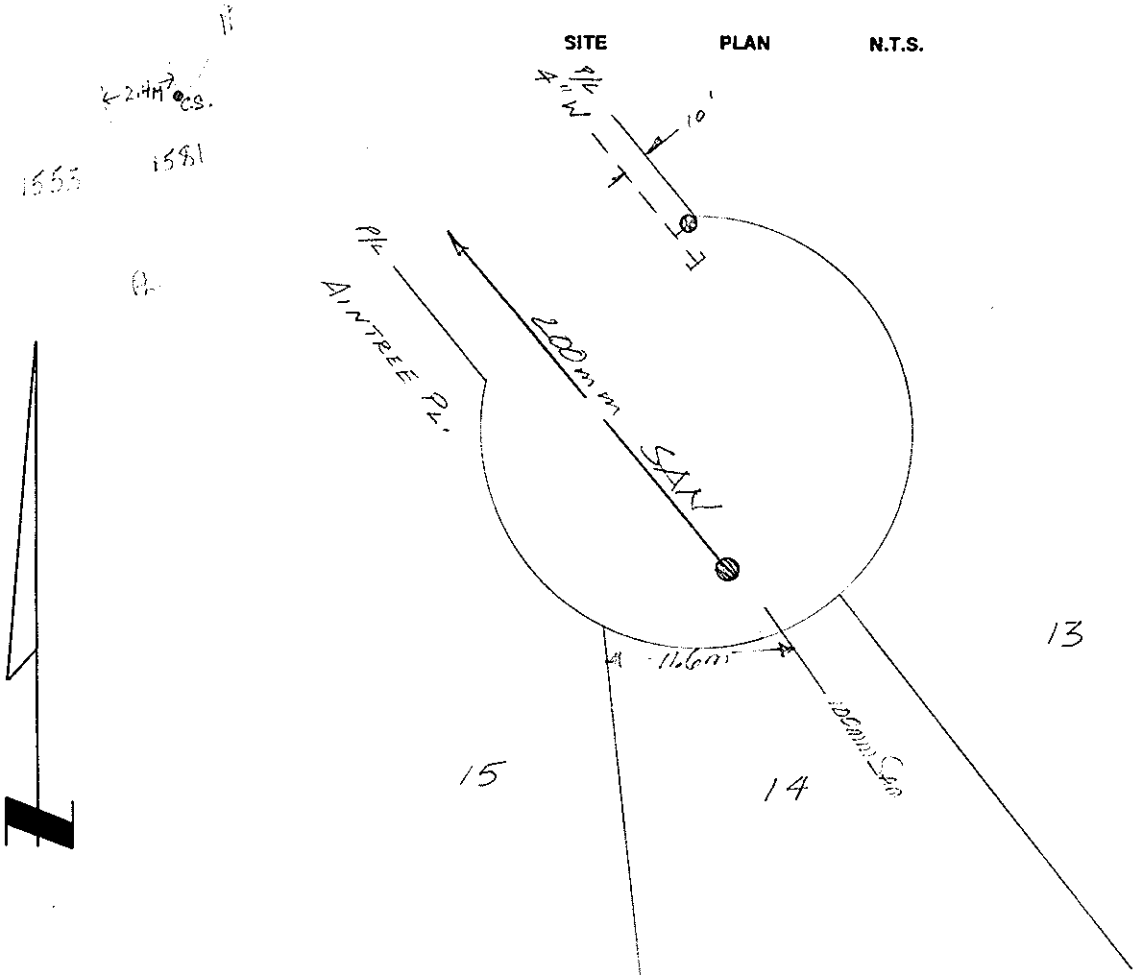
SITE PLAN N.T.S.