# City of Prince George
## HISTORY SHEET

SHEET NUMBER № 3450 **Roll Number** 012066354

**Legal:** LOT'S 77 BLOCK D.L. 2507 PLAN 15185

**Address:** 1305 PARSNIP CRES.

**Sanitary Connection:** # 4575 SIZE MATERIAL INV. CONNECTED

**Water Connection** # 4575 SIZE 20 ϕ mm MATERIAL Cu. METER CONNECTED

**Storm Connection:** # SIZE MATERIAL INV. CONNECTED

**Cash Receipt No's:** WATER SANITARY STORM

CURB FROM PROPERTY LINE 18' PAVEMENT WIDTH

B.C. HYDRO UNDERGROUND CONNECTION

B.C. TELEPHONE UNDERGROUND CONNECTION

INLAND GAS 12' OFFSET

**Information Sheets:**

**Comments:**
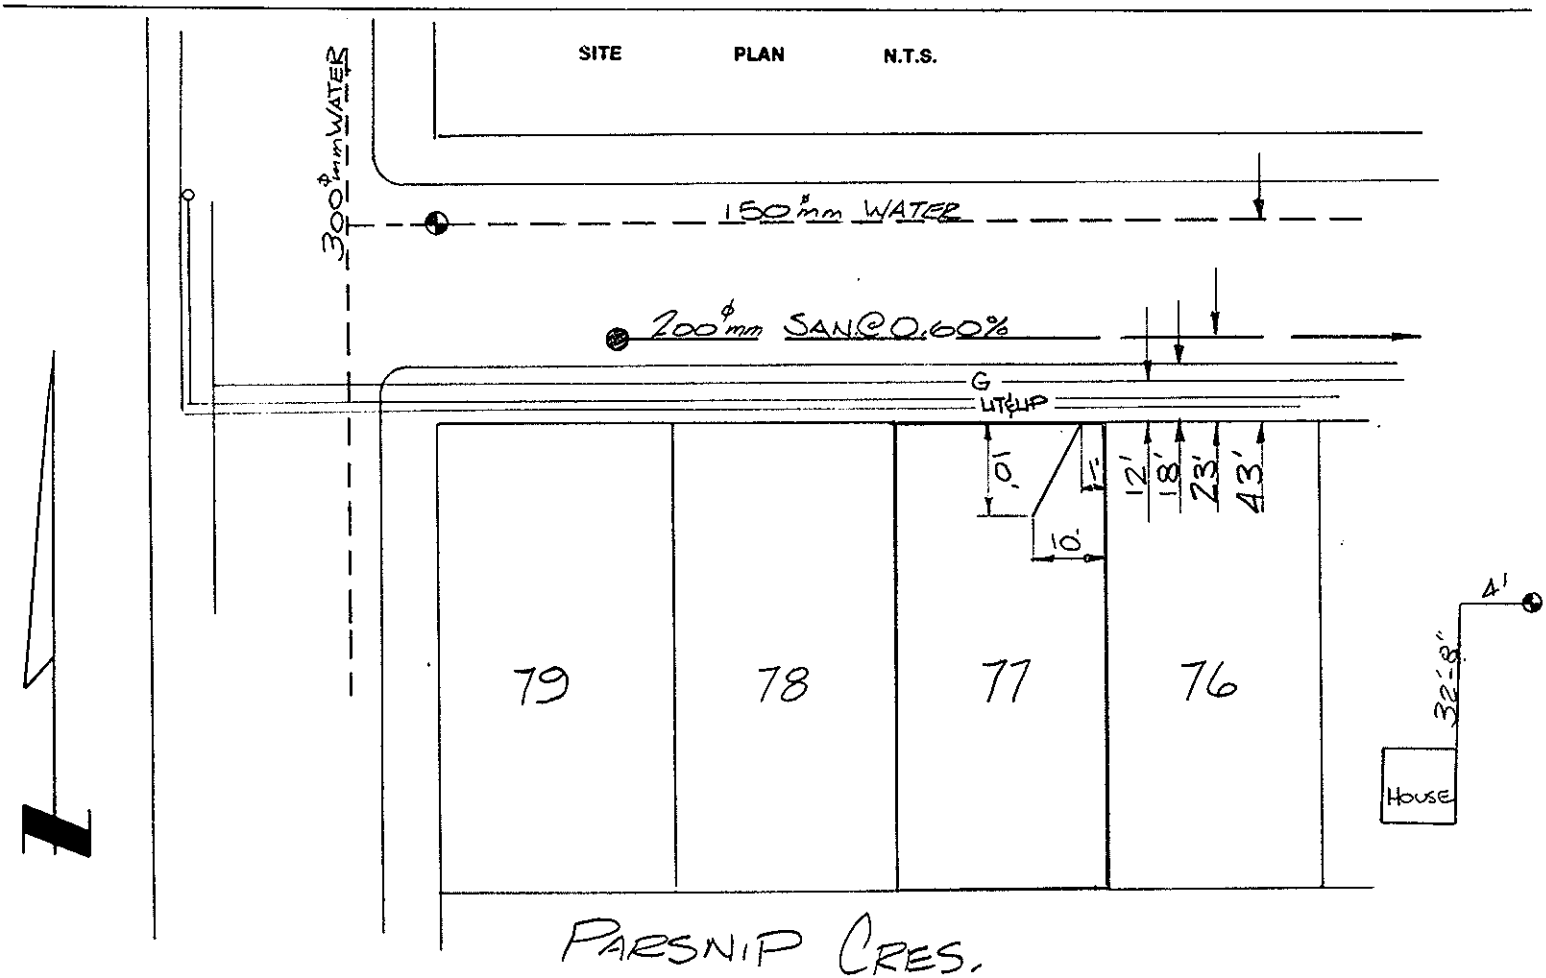
SITE PLAN N.T.S.