City of Prince George
HISTORY SHEET

SHEET NUMBER № 3307 **Roll Number** 012067202

Legal: LOT'S 88 BLOCK D.L. 2507 PLAN 15185

Address: 1452 & 1456 NATION CRES.

Sanitary Connection: # 4586 SIZE MATERIAL INV. CONNECTED

Water Connection # 4586 SIZE 20 mm MATERIAL Cu. METER CONNECTED

Storm Connection: # SIZE MATERIAL INV. CONNECTED

Cash Receipt No's: WATER SANITARY STORM

CURB FROM PROPERTY LINE 16' PAVEMENT WIDTH

B.C. HYDRO UNDERGROUND CONNECTION

B.C. TELEPHONE UNDERGROUND CONNECTION

INLAND GAS 12' OFFSET

Information Sheets:

Comments:

THE INFORMATION CONTAINED HEREIN IS FOR INTERNAL USE ONLY. NOT TO BE RELIED UPON UNLESS CONFIRMED BY SITE INSPECTION AND/OR INVESTIGATION.
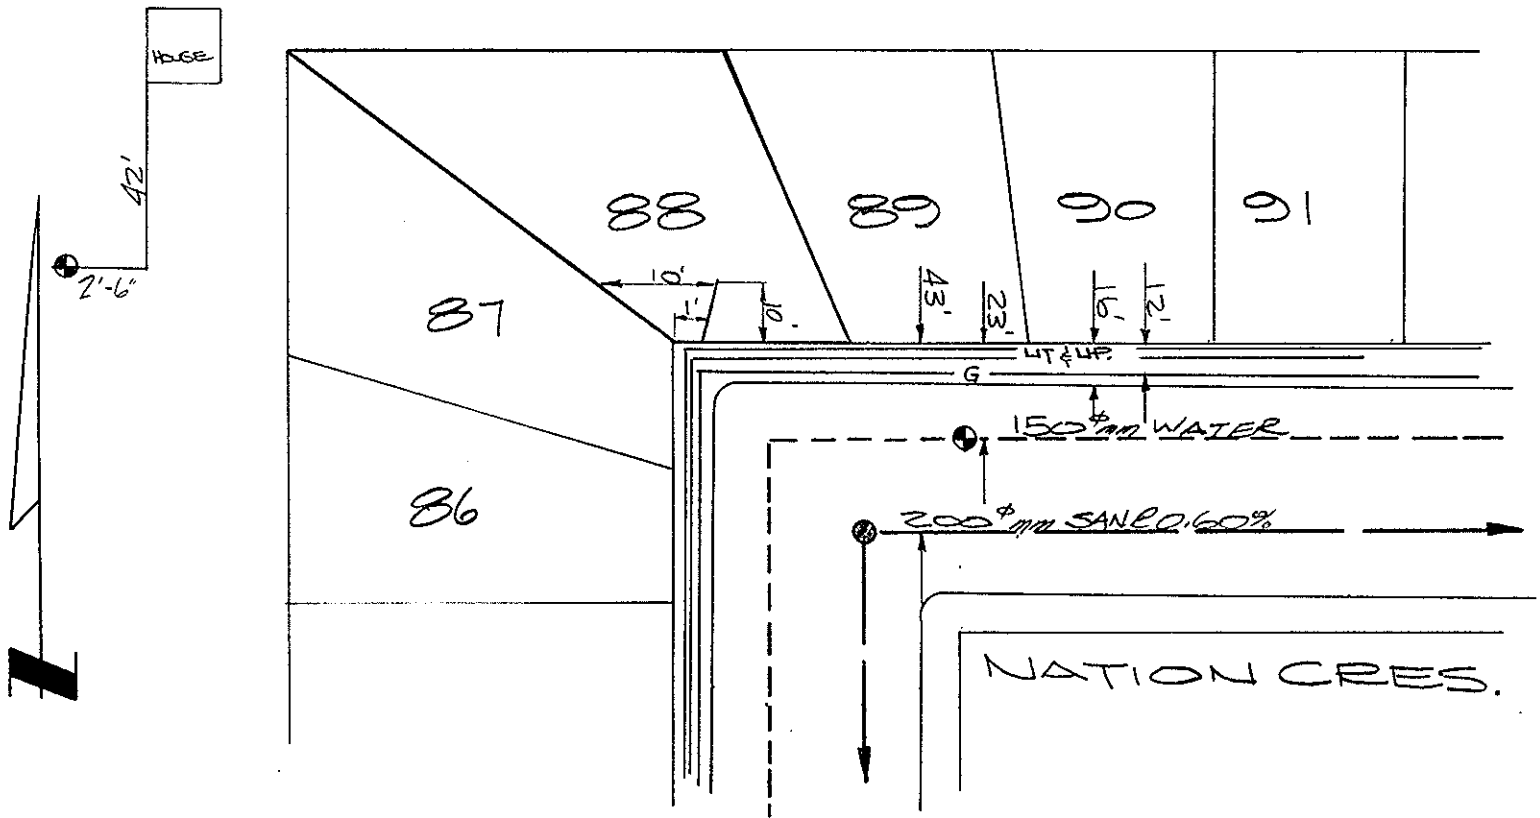
SITE PLAN N.T.S.