City of Prince George
HISTORY SHEET

SHEET NUMBER **Roll Number** 01208595

Legal: LOT'S 22 BLOCK D.L. 1427 PLAN 15089

Address: 357 RILEY DR.

Sanitary Connection: # 5045 SIZE MATERIAL INV. CONNECTED

Water Connection # 5042 SIZE MATERIAL METER CONNECTED

Storm Connection: # SIZE MATERIAL INV. CONNECTED

Cash Receipt No's: WATER SANITARY STORM

CURB FROM PROPERTY LINE PAVEMENT WIDTH

B.C. HYDRO UNDERGROUND CONNECTION

B.C. TELEPHONE UNDERGROUND CONNECTION

INLAND GAS

Information Sheets:

Comments:
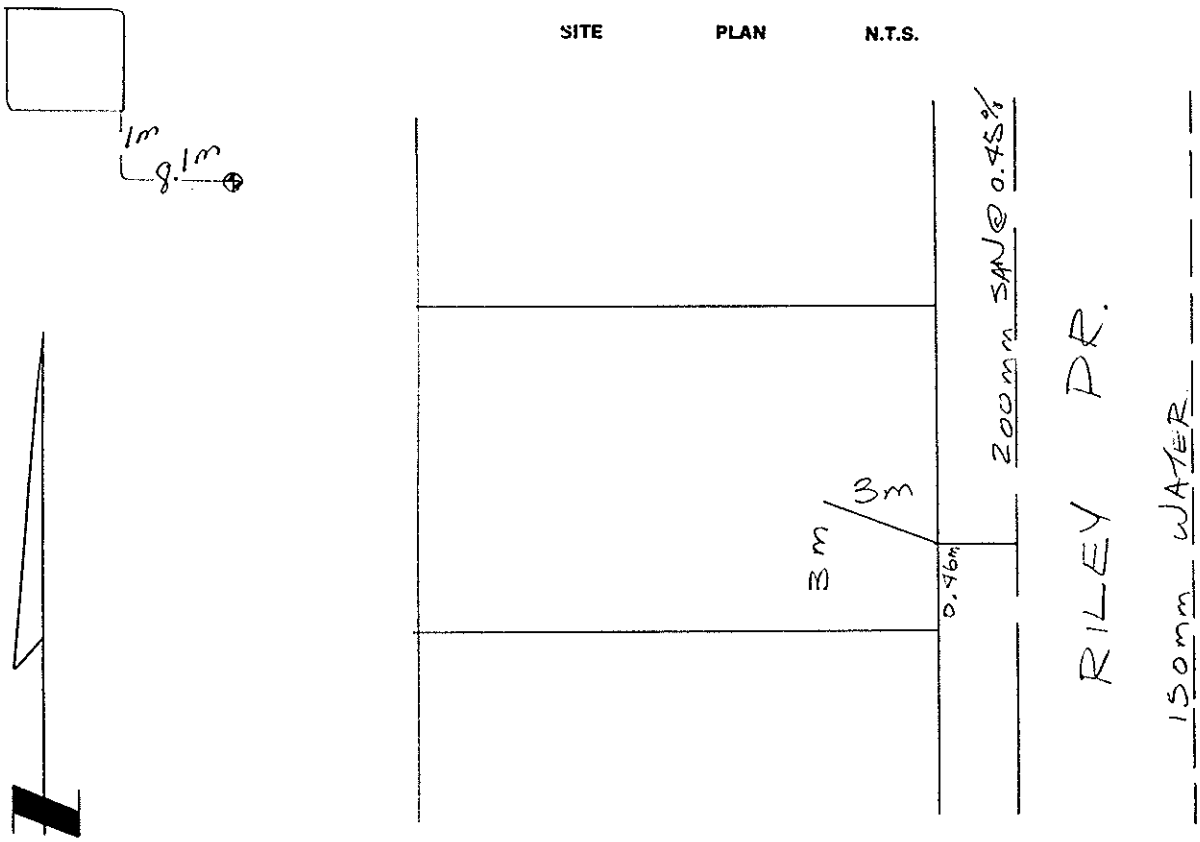
SITE PLAN N.T.S.