City of Prince George
HISTORY SHEET

SHEET NUMBER **Roll Number** 012086681

Legal: LOT'S 21 BLOCK D.L. 1427 PLAN 15089

Address: 341 RILEY DR.

Sanitary Connection: # 5044 SIZE MATERIAL INV. CONNECTED

Water Connection # 5044. SIZE 20mm MATERIAL Cu METER CONNECTED

Storm Connection: # SIZE MATERIAL INV. CONNECTED

Cash Receipt No's: WATER SANITARY STORM

CURB FROM PROPERTY LINE PAVEMENT WIDTH

B.C. HYDRO UNDERGROUND CONNECTION

B.C. TELEPHONE UNDERGROUND CONNECTION

INLAND GAS

Information Sheets:

Comments:

The information contained herein is for internal use only. Not to be relied upon unless confirmed by site inspection and/or investigation.
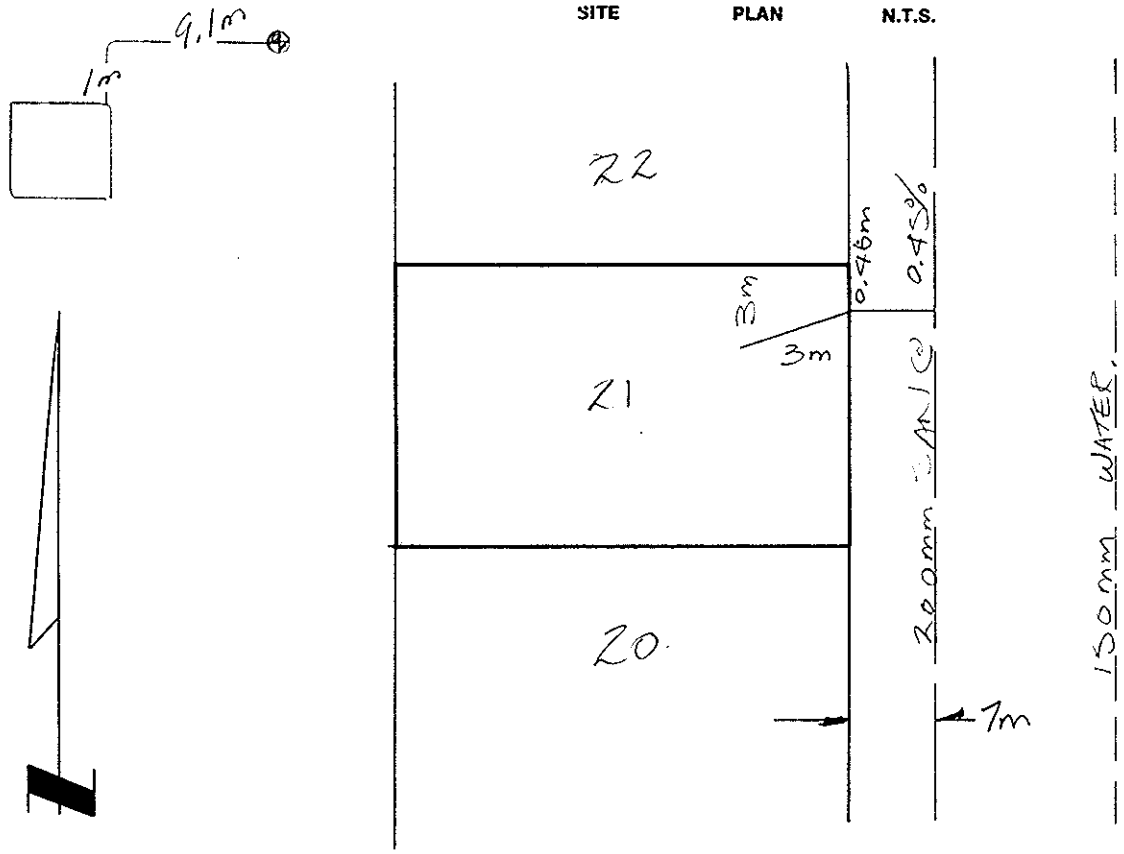
SITE PLAN N.T.S.