U12 1366

City of Prince George
HISTORY SHEET

SHEET NUMBER 3157 Roll Number

Legal: LOT'S 2 BLOCK 308 & 288X D.L. 343 PLAN 14716

Address: 1800 & 1802 KENWOOD ST.

Sanitary Connection: # 3991 SIZE MATERIAL INV. CONNECTED

Water Connection # 3792 SIZE 3/4 MATERIAL Cu METER CONNECTED

Storm Connection: # SIZE MATERIAL INV. CONNECTED

Cash Receipt No's: WATER SANITARY STORM

CURB FROM PROPERTY LINE PAVEMENT WIDTH

B.C. HYDRO O.H. UNDERGROUND CONNECTION

B.C. TELEPHONE O.H. UNDERGROUND CONNECTION

INLAND GAS AS SHOWN

Information Sheets:

Comments:
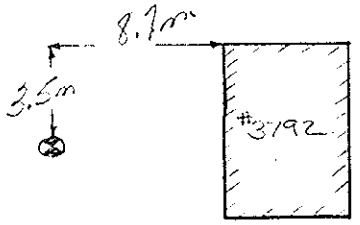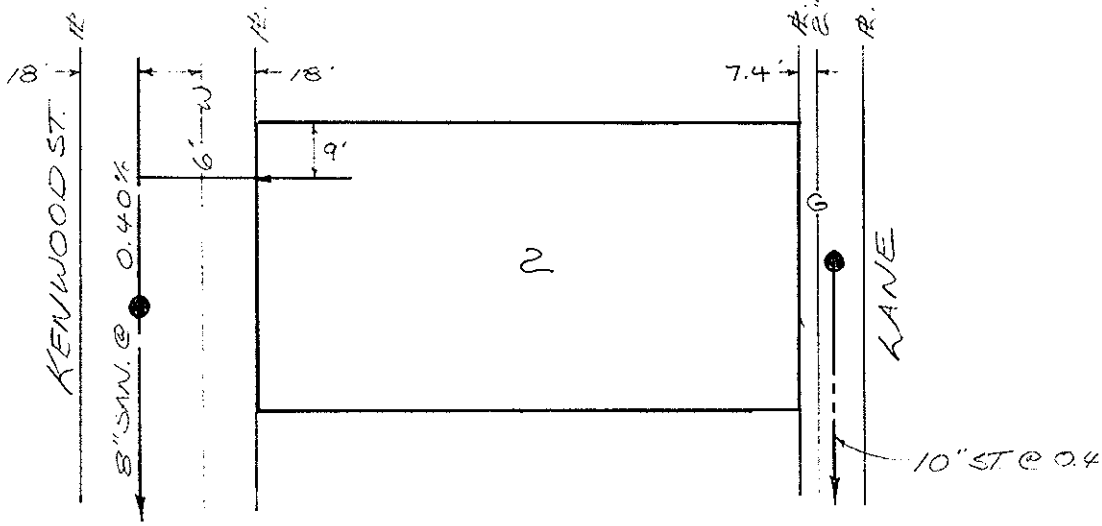
SITE PLAN N.T.S.