City of Prince George
HISTORY SHEET

SHEET NUMBER **Roll Number** 312254681

Legal: LOT'S 35 BLOCK D.L. 931 PLAN 15198.

Address: 398 Quinn St

Sanitary Connection: # 3648 SIZE MATERIAL INV. CONNECTED

Water Connection # 3648 SIZE 20mm MATERIAL Cu METER CONNECTED

Storm Connection: # SIZE MATERIAL INV. CONNECTED

Cash Receipt No's: WATER SANITARY STORM

CURB FROM PROPERTY LINE PAVEMENT WIDTH

B.C. HYDRO UNDERGROUND CONNECTION

B.C. TELEPHONE UNDERGROUND CONNECTION

INLAND GAS

Information Sheets:

Comments:
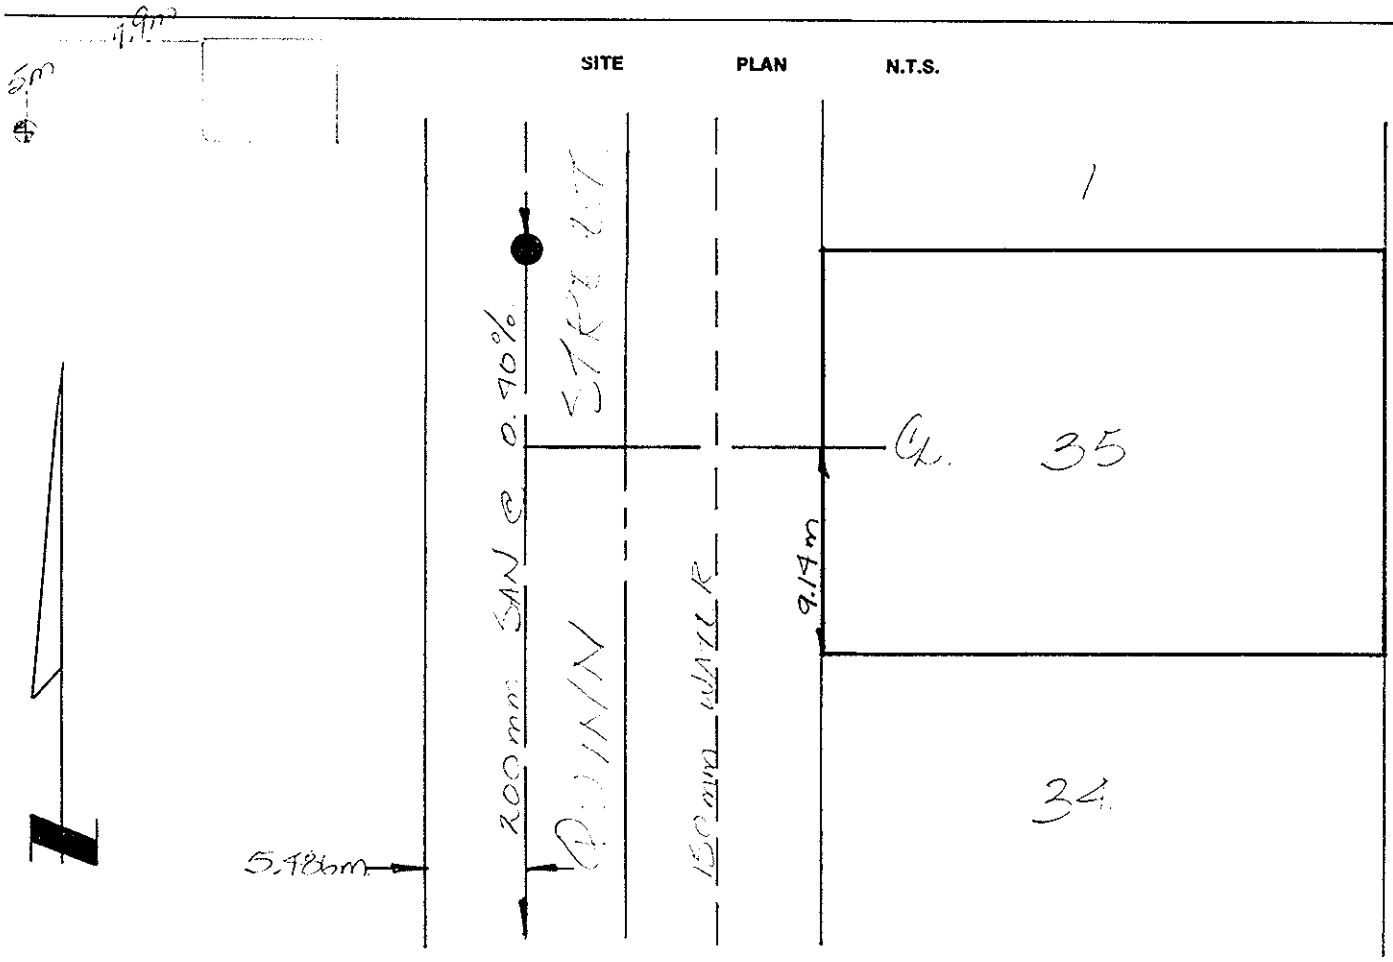
SITE PLAN N.T.S.