City of Prince George
HISTORY SHEET

SHEET NUMBER **Roll Number** 0122695.14

Legal: LOT'S 23 BLOCK D.L. 938 PLAN 13519

Address: 933 NORTH PATTERSON STREET

Sanitary Connection: # 3543 SIZE MATERIAL INV. CONNECTED

Water Connection # 3543 SIZE 20mm MATERIAL COPPER METER CONNECTED

Storm Connection: # SIZE MATERIAL INV. CONNECTED

Cash Receipt No's: WATER SANITARY STORM

CURB FROM PROPERTY LINE PAVEMENT WIDTH

B.C. HYDRO UNDERGROUND CONNECTION

B.C. TELEPHONE UNDERGROUND CONNECTION

INLAND GAS

Information Sheets:

Comments:

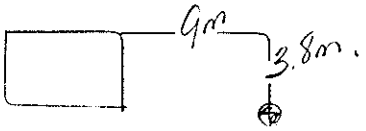
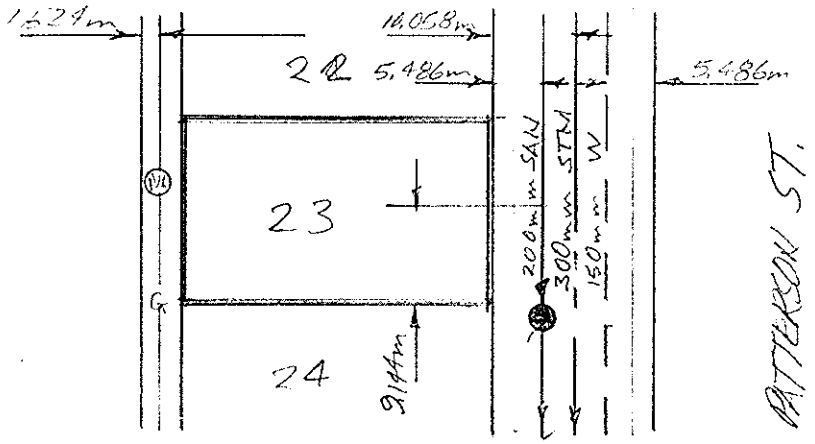
SITE PLAN N.T.S.