City of Prince George
HISTORY SHEET

D 5

SHEET NUMBER

Roll Number 012270148

Legal: LOT'S 36 BLOCK D.L. 938 PLAN 13549

Address: 370 NORTH PATTERSON STREET

Sanitary Connection: # 3530 SIZE MATERIAL INV. CONNECTED

Water Connection # 3530 SIZE 20mm MATERIAL COPPER METER CONNECTED

Storm Connection: # SIZE MATERIAL INV. CONNECTED

Cash Receipt No's: WATER SANITARY STORM

CURB FROM PROPERTY LINE PAVEMENT WIDTH

B.C. HYDRO UNDERGROUND CONNECTION

B.C. TELEPHONE UNDERGROUND CONNECTION

INLAND GAS

Information Sheets:

Comments:
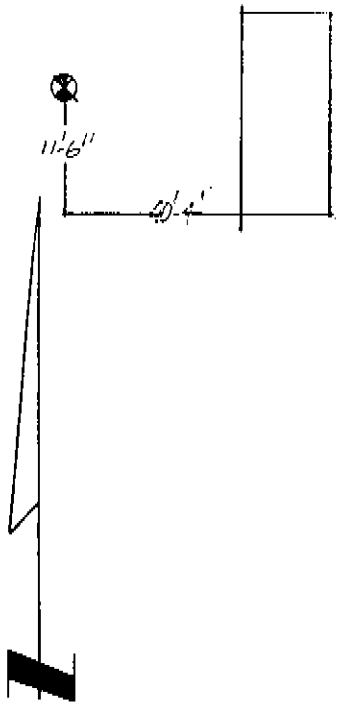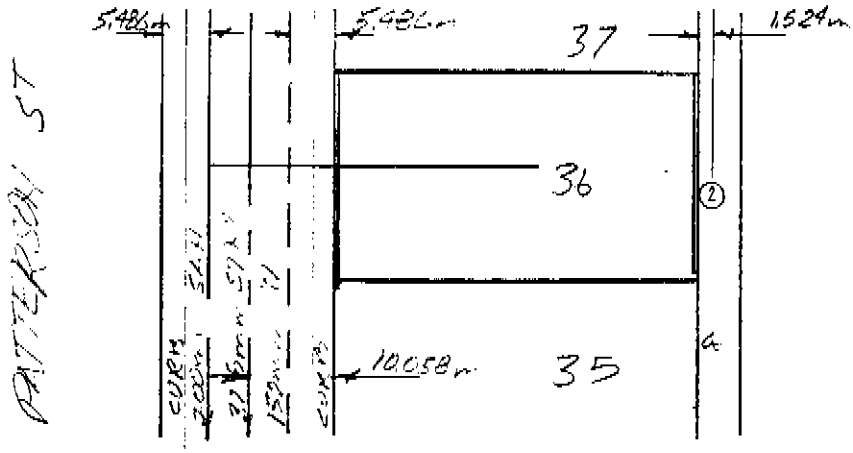
SITE PLAN N.T.S.