City of Prince George
HISTORY SHEET

0

SHEET NUMBER 11265 **Roll Number** 01227156

Legal: LOT'S 14 BLOCK D.L. 2099 PLAN 13428

Address: 7979 TOOMBS DR.

Sanitary Connection: # SIZE MATERIAL INV. CONNECTED

Water Connection # SIZE MATERIAL METER CONNECTED

Storm Connection: # SIZE MATERIAL INV. CONNECTED

Cash Receipt No's: WATER SANITARY STORM

CURB FROM PROPERTY LINE PAVEMENT WIDTH

B.C. HYDRO UNDERGROUND CONNECTION

B.C. TELEPHONE UNDERGROUND CONNECTION

INLAND GAS

Information Sheets:

Comments:
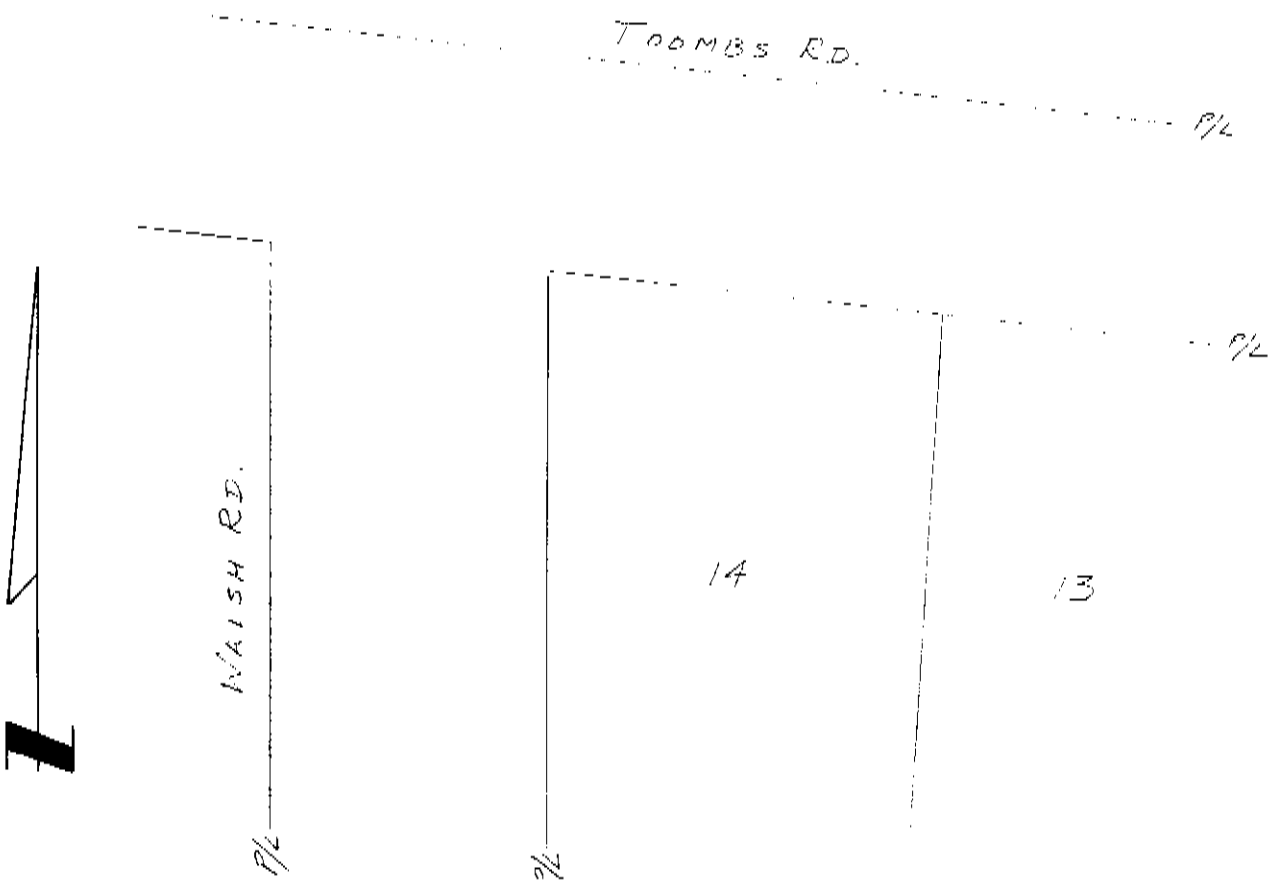
SITE PLAN N.T.S.