City of Prince George
HISTORY SHEET

SHEET NUMBER [redacted] **Roll Number** 0122-7463

Legal: LOT'S 82 BLOCK D.L. 1599 PLAN 13589

Address: 7264 EUGENE RD. (A GAUTHIER)

Sanitary Connection: # 16259 SIZE 100mm MATERIAL INV. CONNECTED

Water Connection # 12047 SIZE 20mm MATERIAL Cu METER CONNECTED

Storm Connection: # SIZE MATERIAL INV. CONNECTED

Cash Receipt No's: WATER 1301 SANITARY STORM

CURB FROM PROPERTY LINE PAVEMENT WIDTH

B.C. HYDRO UNDERGROUND CONNECTION

B.C. TELEPHONE UNDERGROUND CONNECTION

INLAND GAS as shown

Information Sheets:
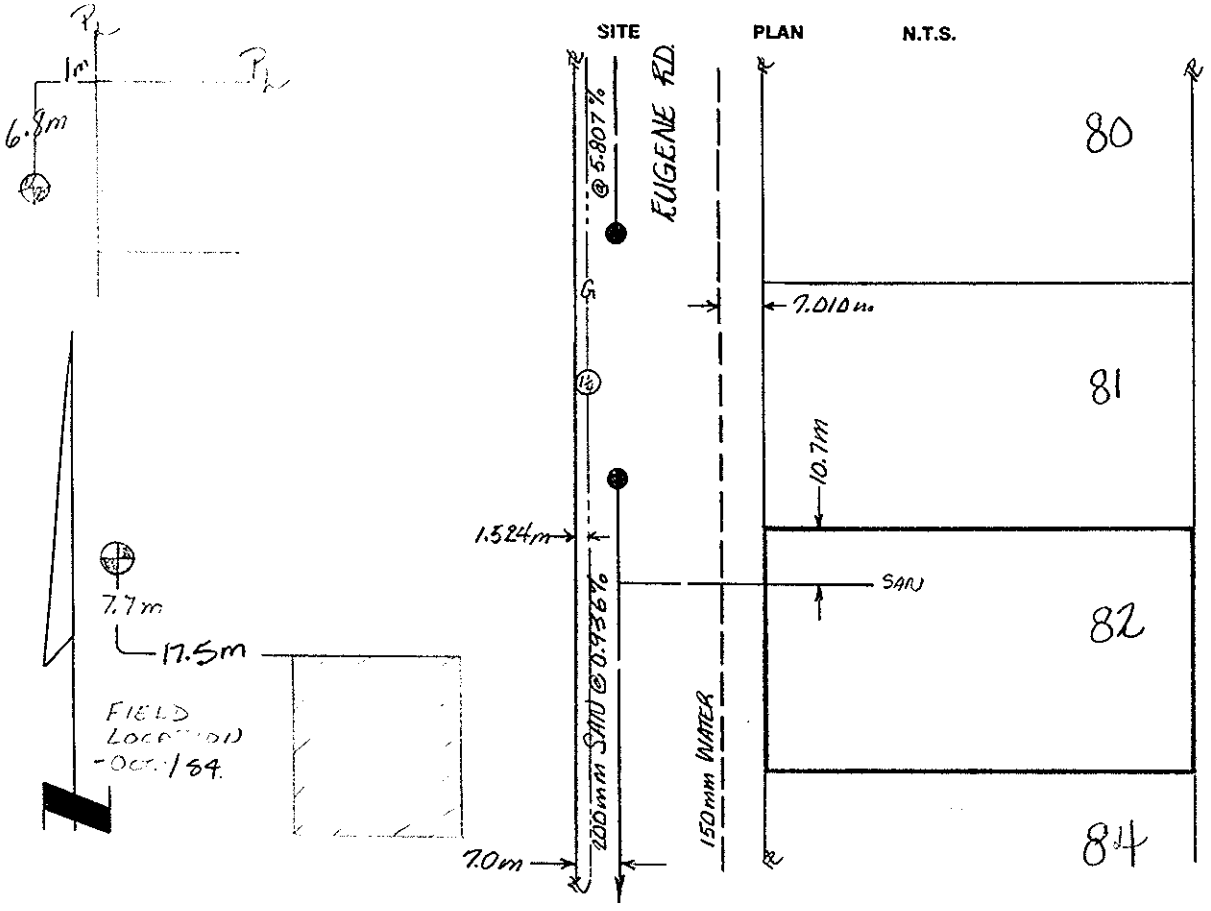
Comments: