City of Prince George
HISTORY SHEET

SHEET NUMBER 1369 **Roll Number**

Legal: LOT'S 12-13 BLOCK 158 D.L. 343 PLAN 1268

Address: 557-555 WINNIPEG ST.

Sanitary Connection: # 61 SIZE - MATERIAL - INV. 1895.60 CONNECTED YES

Water Connection # 2809 SIZE 3/4" MATERIAL COPPER METER - CONNECTED YES

Storm Connection: # - SIZE - MATERIAL - INV. - CONNECTED -

Cash Receipt No's: WATER SANITARY STORM

CURB FROM PROPERTY LINE 16' PAVEMENT WIDTH 48'

B.C. HYDRO O.H. UNDERGROUND CONNECTION

B.C. TELEPHONE UNDERGROUND CONNECTION ON 6th AVE. 6'-5" FROM P/L N

INLAND GAS IN LANE ∅ 2" MAIN

Information Sheets:

Comments: BENCH MARK # 75-68 ELEVATION = 190.488

S.I.P. S.E. CORNER 6th AND EDMONTON

LEVEL BOOK # 21
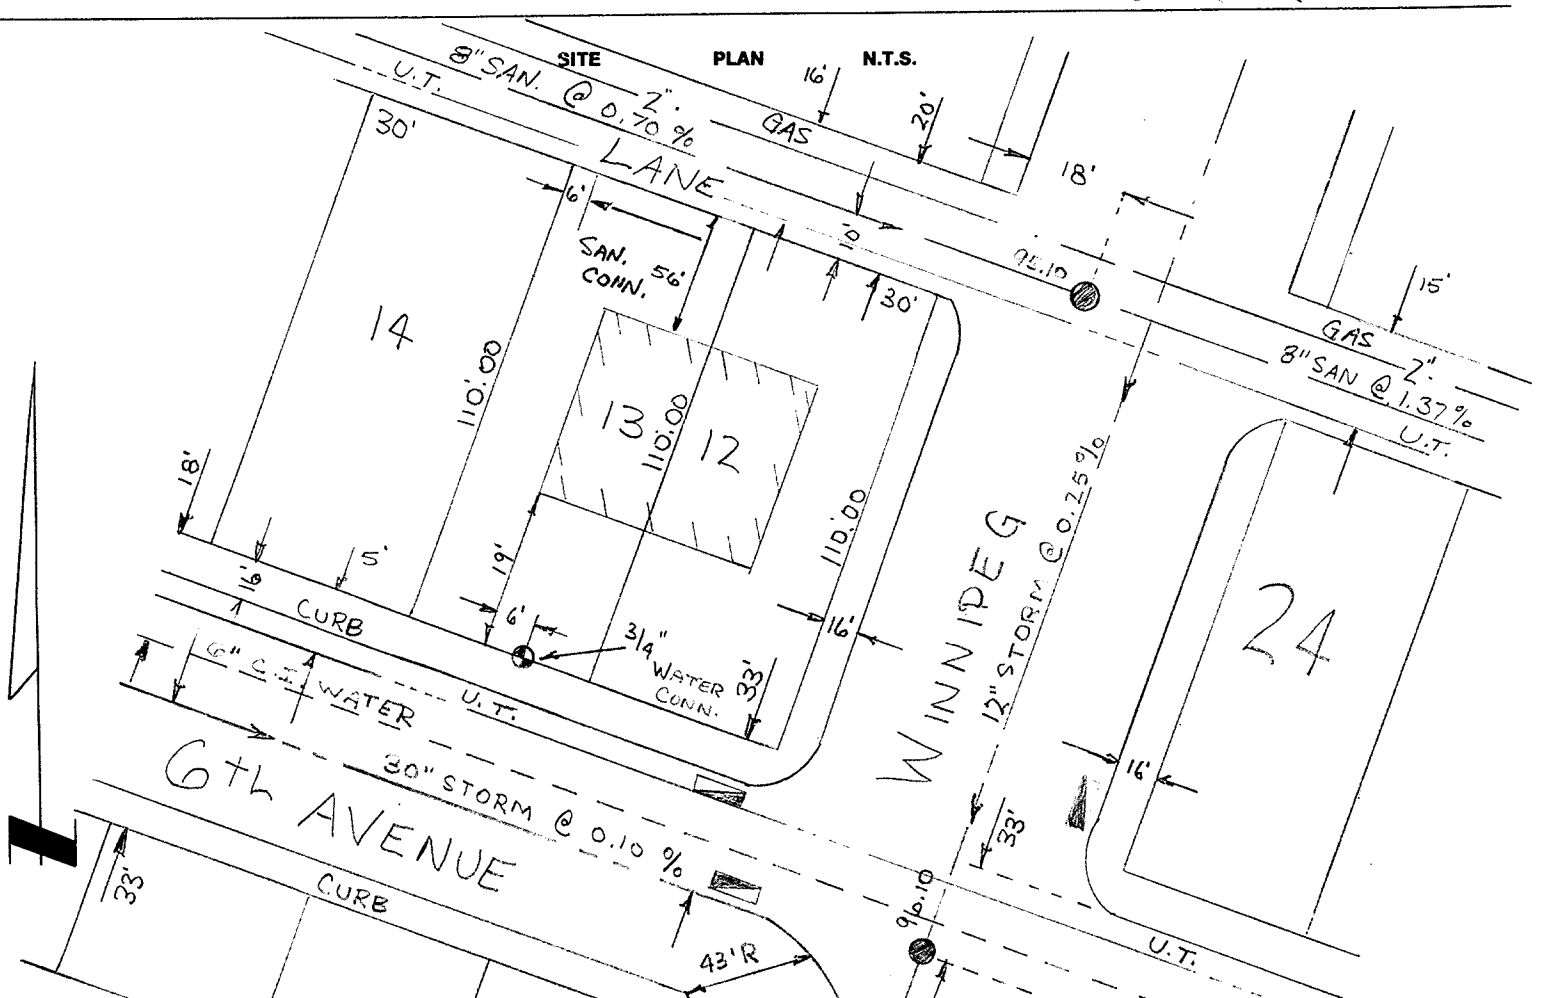
SITE PLAN N.T.S.