City of Prince George
HISTORY SHEET

012323365 HR

SHEET NUMBER 7592 **Roll Number**

Legal: LOT'S 4 BLOCK D.L. 4039 PLAN 13991

Address: 2925 MINNOTT DR.

Sanitary Connection: # 16030 SIZE 100MM MATERIAL PVC INV. CONNECTED

Water Connection # SIZE 20 MM MATERIAL COPPER METER CONNECTED

Storm Connection: # SIZE MATERIAL INV. CONNECTED

Cash Receipt No's: WATER SANITARY 1244 STORM

CURB FROM PROPERTY LINE PAVEMENT WIDTH

B.C. HYDRO O/H UNDERGROUND CONNECTION

B.C. TELEPHONE O/H UNDERGROUND CONNECTION

INLAND GAS AS SHOWN

Information Sheets:

Comments:

THE INFORMATION CONTAINED HEREIN IS FOR INTERNAL USE ONLY. NOT TO BE RELIED UPON UNLESS CONFIRMED BY SITE INSPECTION AND/OR INVESTIGATION.
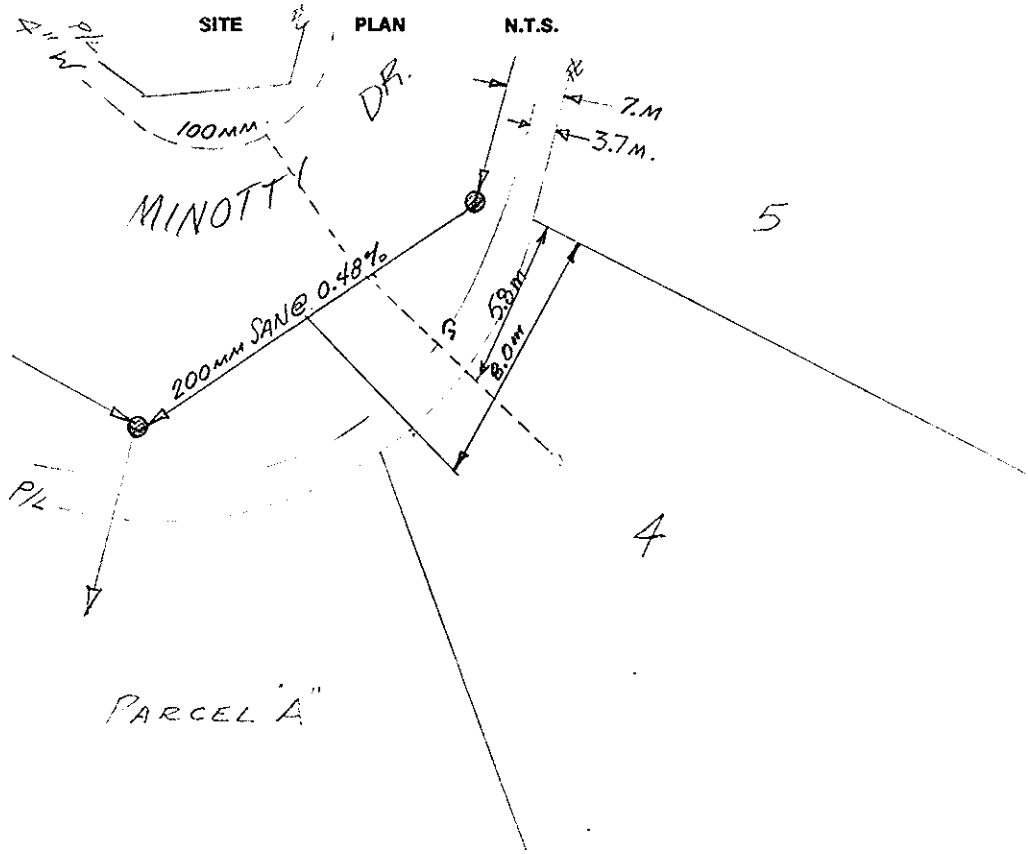
SITE PLAN N.T.S.