City of Prince George
HISTORY SHEET

SHEET NUMBER [redacted] **Roll Number** 01234/894

Legal: LOT'S 26 BLOCK D.L. 2003 PLAN 13053

Address: 6267 LALONDE RD.

Sanitary Connection: # 16339 SIZE 100mm MATERIAL INV. CONNECTED

Water Connection # SIZE 20 mm MATERIAL METER CONNECTED

Storm Connection: # SIZE MATERIAL INV. CONNECTED

Cash Receipt No's: WATER 0522 SANITARY STORM

CURB FROM PROPERTY LINE PAVEMENT WIDTH

B.C. HYDRO UNDERGROUND CONNECTION

B.C. TELEPHONE UNDERGROUND CONNECTION

INLAND GAS

Information Sheets:

Comments:
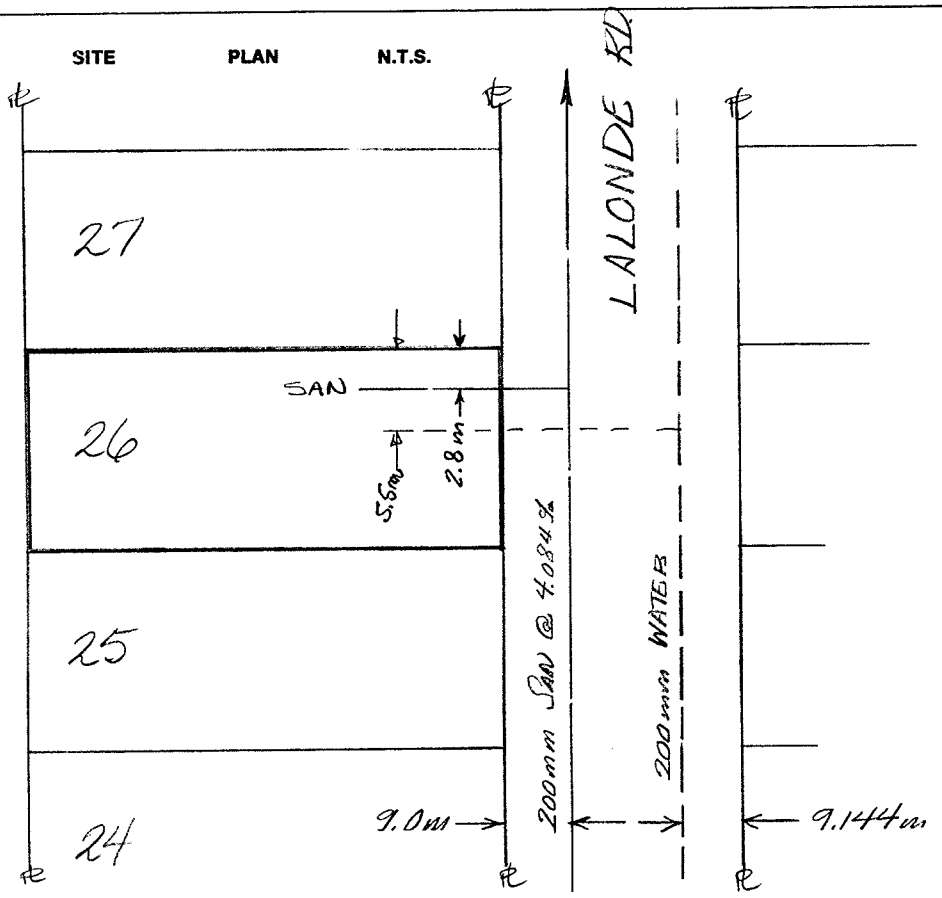
SITE PLAN N.T.S.