City of Prince George
HISTORY SHEET

SHEET NUMBER

Roll Number 11402

Legal: LOT'S A & B BLK 193 D.L. 936 PLAN 696

Address: 1575 CARNEY STREET

Sanitary Connection: # 3994 SIZE 100mm MATERIAL AC INV. CONNECTED

Water Connection # 3797 SIZE 20mm MATERIAL Cu METER CONNECTED

Storm Connection: # SIZE MATERIAL INV. CONNECTED

Cash Receipt No's: WATER SANITARY 2068 STORM

CURB FROM PROPERTY LINE PAVEMENT WIDTH

B.C. HYDRO UNDERGROUND CONNECTION

B.C. TELEPHONE UNDERGROUND CONNECTION

INLAND GAS

Information Sheets:

Comments:
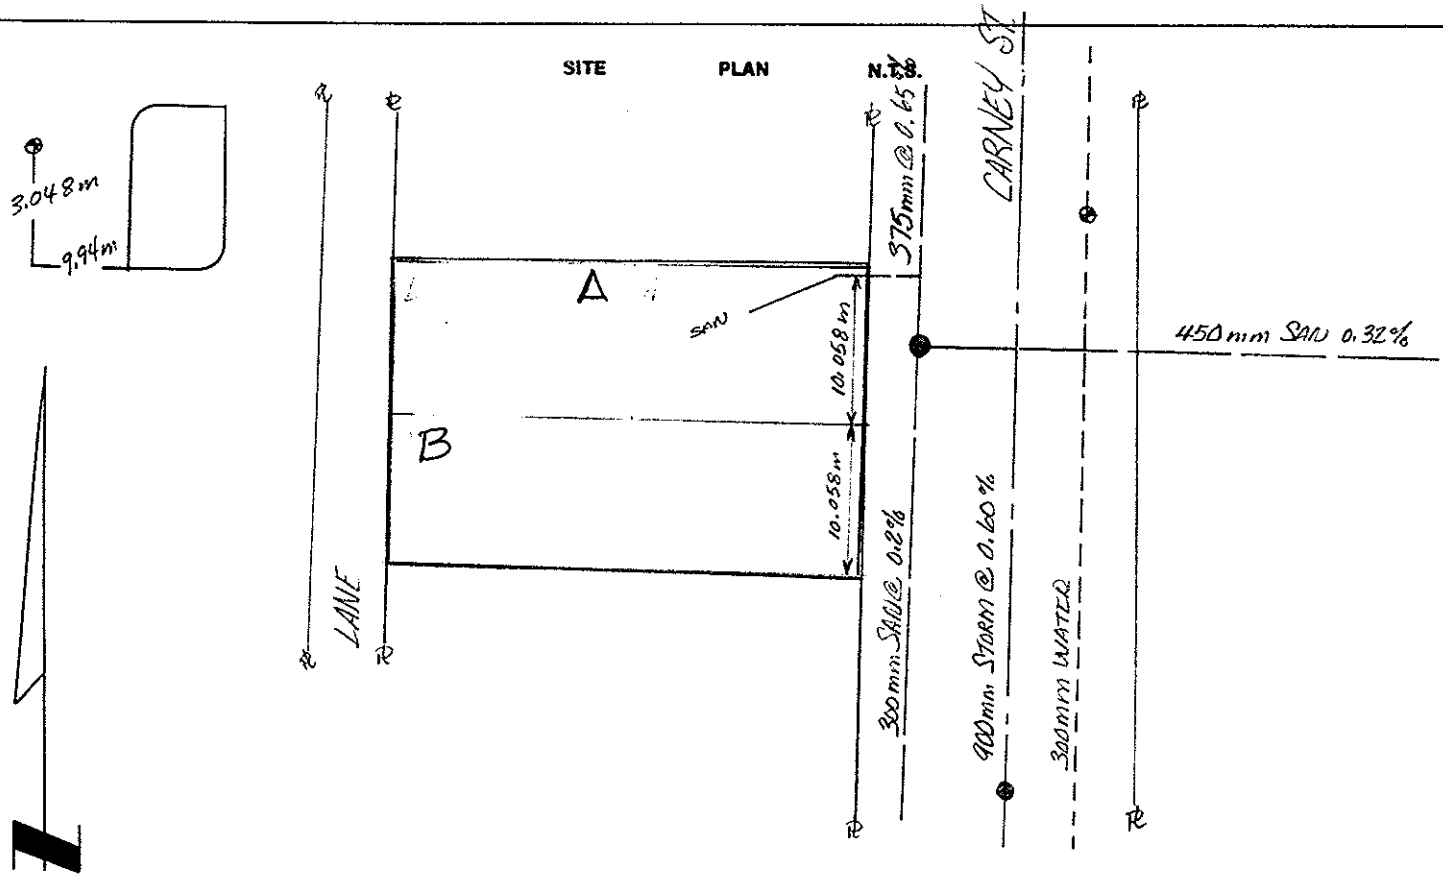
SITE PLAN N.T.S.