City of Prince George
HISTORY SHEET

FM

SHEET NUMBER **Roll Number** 312535834

Legal: LOT'S 27 BLOCK D.L. 2609 PLAN 342 535

Address: 761 OCHAKWIN CRESCENT

Sanitary Connection: # 10724 SIZE 4" MATERIAL A.C. INV. 2005.57 CONNECTED

Water Connection # 10724 SIZE 3/4" MATERIAL COPPER METER No CONNECTED

Storm Connection: # 627 SIZE 4" MATERIAL A.C. INV. 2007.81 CONNECTED

Cash Receipt No's: WATER SANITARY STORM

CURB FROM PROPERTY LINE 16' PAVEMENT WIDTH 34'

B.C. HYDRO UNDERGROUND CONNECTION

B.C. TELEPHONE UNDERGROUND CONNECTION

INLAND GAS

Information Sheets:

Comments:
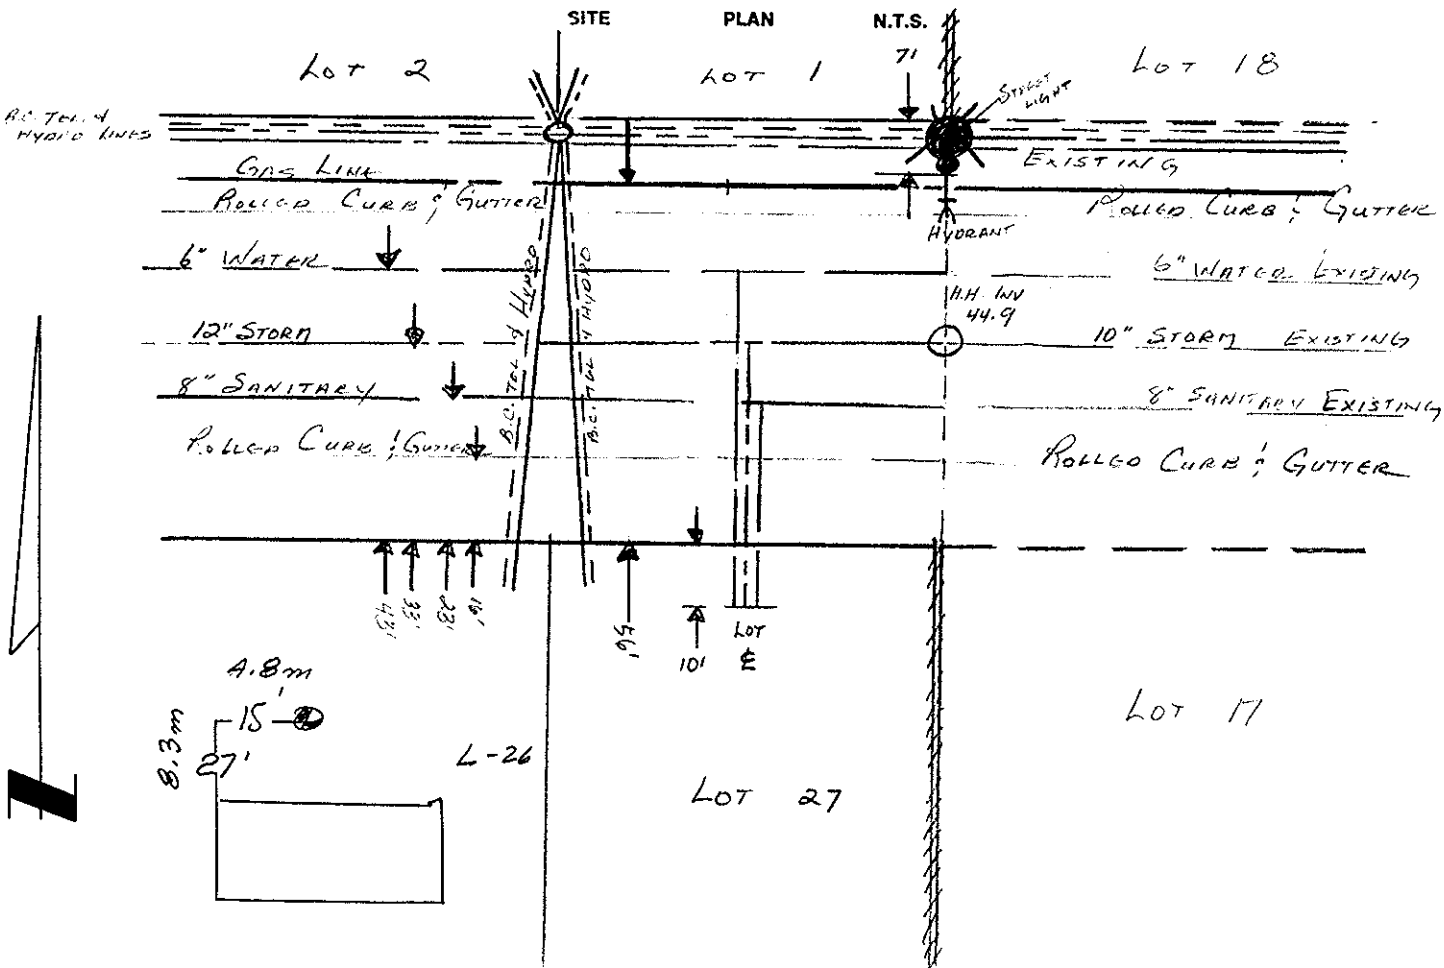
SITE PLAN N.T.S.