City of Prince George
HISTORY SHEET

012579343

SHEET NUMBER **7583** **Roll Number**

Legal: LOT'S 8 BLOCK D.L. 4039 PLAN 11006

Address: 3047 MINNOTTI DR.

Sanitary Connection: # 13315 SIZE 4"Ø MATERIAL INV. 2120.36 CONNECTED

Water Connection # SIZE 20mm MATERIAL CU METER CONNECTED

Storm Connection: # SIZE MATERIAL INV. CONNECTED

Cash Receipt No's: WATER SANITARY 1815 STORM

CURB FROM PROPERTY LINE PAVEMENT WIDTH

B.C. HYDRO UNDERGROUND CONNECTION

B.C. TELEPHONE UNDERGROUND CONNECTION

INLAND GAS

Information Sheets:

Comments:
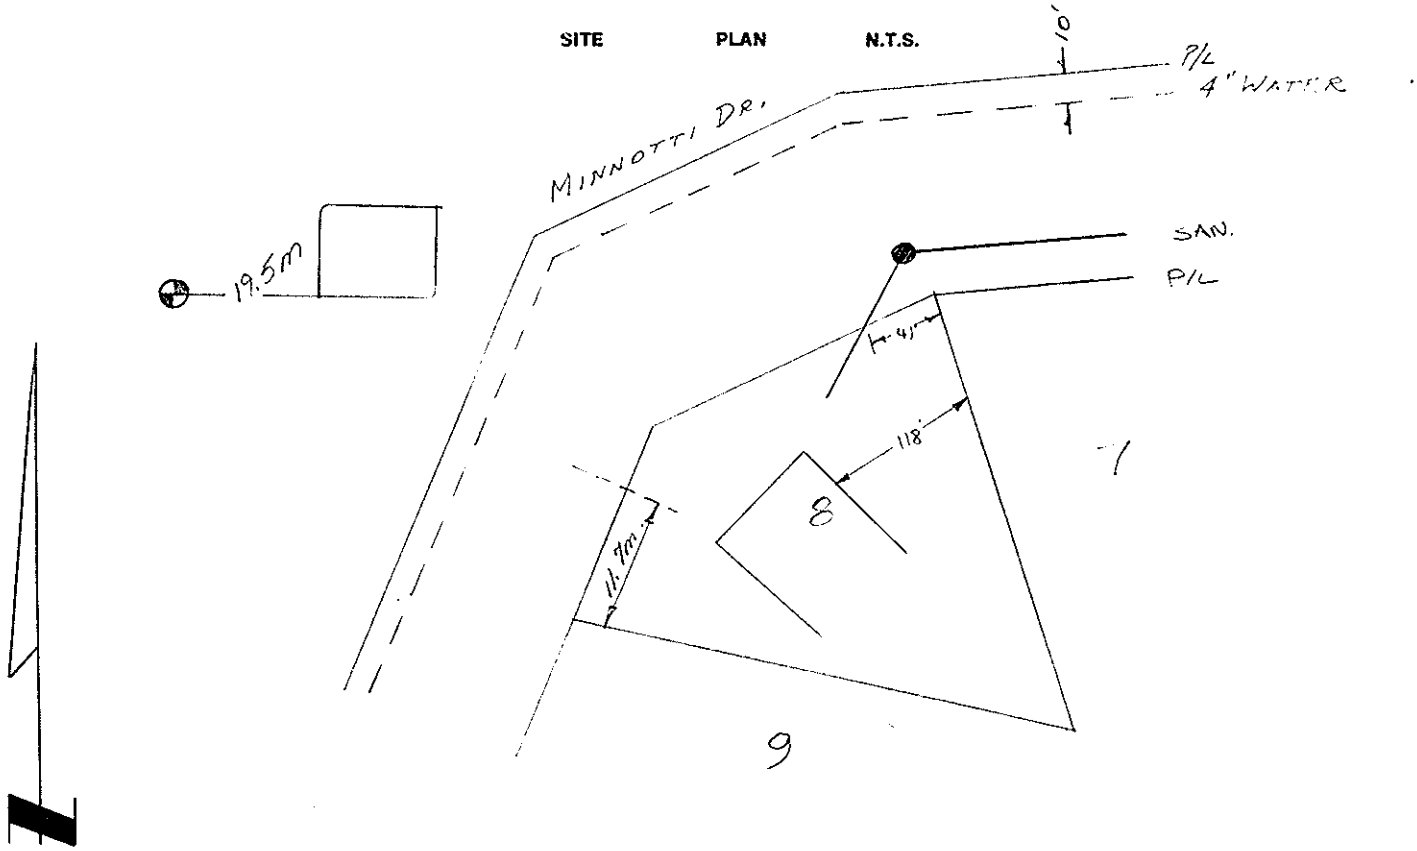
SITE PLAN N.T.S.