0185972 20
0185972 28

City of Prince George
HISTORY SHEET

SHEET NUMBER **5110** **Roll Number**

Legal: LOT'S 17 & 18 BLOCK 228 D.L. 343 PLAN 1268

Address: 1450 FIR ST.

Sanitary Connection: # 2705 SIZE ? MATERIAL INV. ? CONNECTED

Water Connection # 2508 SIZE ½" MATERIAL IRON METER CONNECTED

Storm Connection: # SIZE MATERIAL INV. CONNECTED

Cash Receipt No's: WATER SANITARY STORM

CURB FROM PROPERTY LINE PAVEMENT WIDTH

B.C. HYDRO O.H. UNDERGROUND CONNECTION

B.C. TELEPHONE O.H. UNDERGROUND CONNECTION

INLAND GAS AS SHOWN

Information Sheets:

Comments:

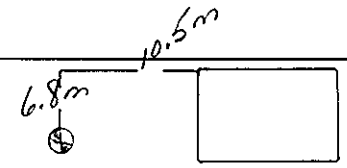
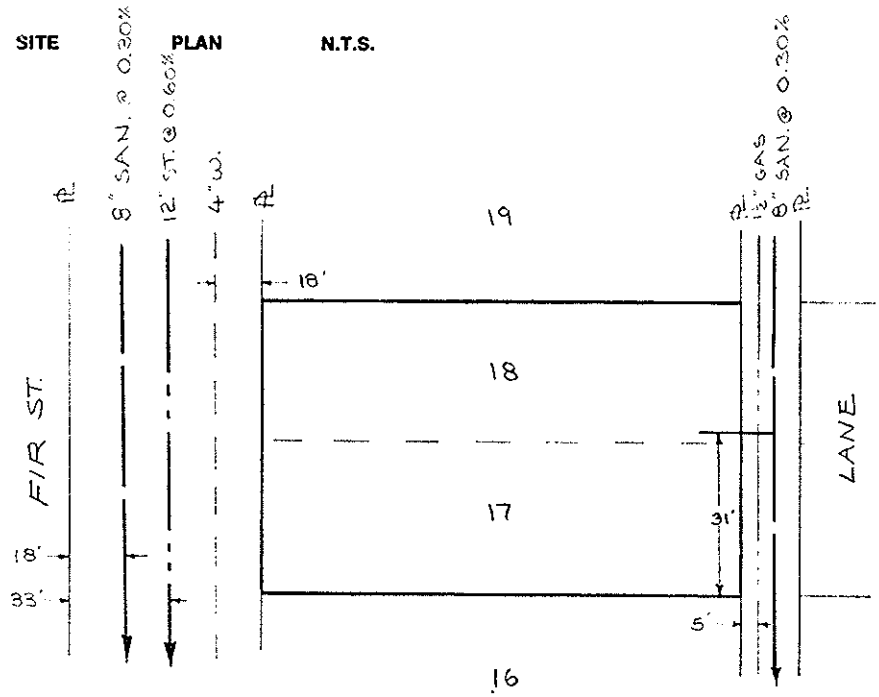
SITE PLAN N.T.S.