City of Prince George
HISTORY SHEET

SHEET NUMBER 2 of 37 ~~ROLL~~ NUMBER 012608921

Legal: LOT 4 D.L. 1599 PLAN 11093

Address: **~~15845~~ HEYER ROAD**

Sanitary Connection:# SIZE: 100mm MATERIAL: PVC INV. **730.70** CONNECTED

Water Connection:# 12385 SIZE: 3/4" MATERIAL: Cu METER

Storm Connection:# SIZE MATERIAL INV. CONNECTED

Cash Receipt No's: WATER 2121 SANITARY STORM

CURB FROM PROPERTY LINE PAVEMENT WIDTH

B.C. HYDRO U/G CONNECTION

B.C. TELEPHONE U/G CONNECTION

B.C. GAS

Information Sheets:

Comments:
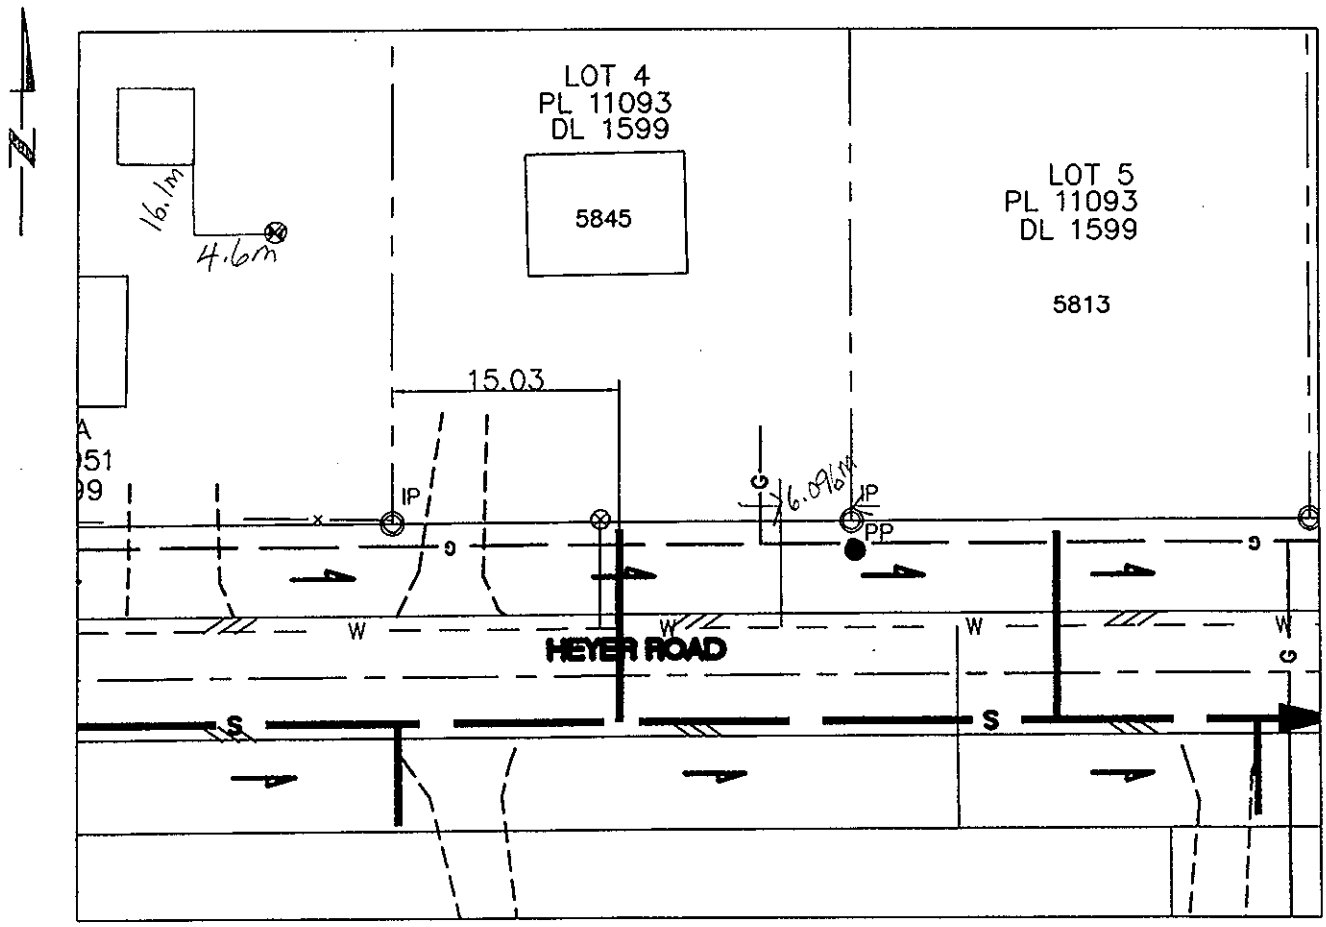
THE INFORMATION CONTAINED HEREIN IS FOR INTERNAL USE ONLY.
NOT TO BE RELIED UPON UNLESS CONFIRMED BY THE SITE INSPECTION AND/OR INVESTIGATION