City of Prince George
HISTORY SHEET

SHEET NUMBER 2954 **Roll Number** 012617598

Legal: LOT'S 44 BLOCK D.L. 8182 PLAN 10739

Address: 2763 SANDERSON RD.

Sanitary Connection: # 12173 SIZE 4" MATERIAL P.V.C. INV. CONNECTED

Water Connection # 12173 SIZE 3/4" MATERIAL P.V.C. METER CONNECTED

Storm Connection: # SIZE MATERIAL INV. CONNECTED

Cash Receipt No's: WATER 2070 SANITARY 2071 STORM

CURB FROM PROPERTY LINE PAVEMENT WIDTH

B.C. HYDRO O.H. UNDERGROUND CONNECTION

B.C. TELEPHONE O.H. UNDERGROUND CONNECTION

INLAND GAS ON SANDERSON ϕ 1 1/4" MAIN

Information Sheets:

Comments: BENCH MARK # 1720-79 ELEVATION = 1949.72
H.S. N-SIDE SANDERSON, WESTWOOD-RYAN
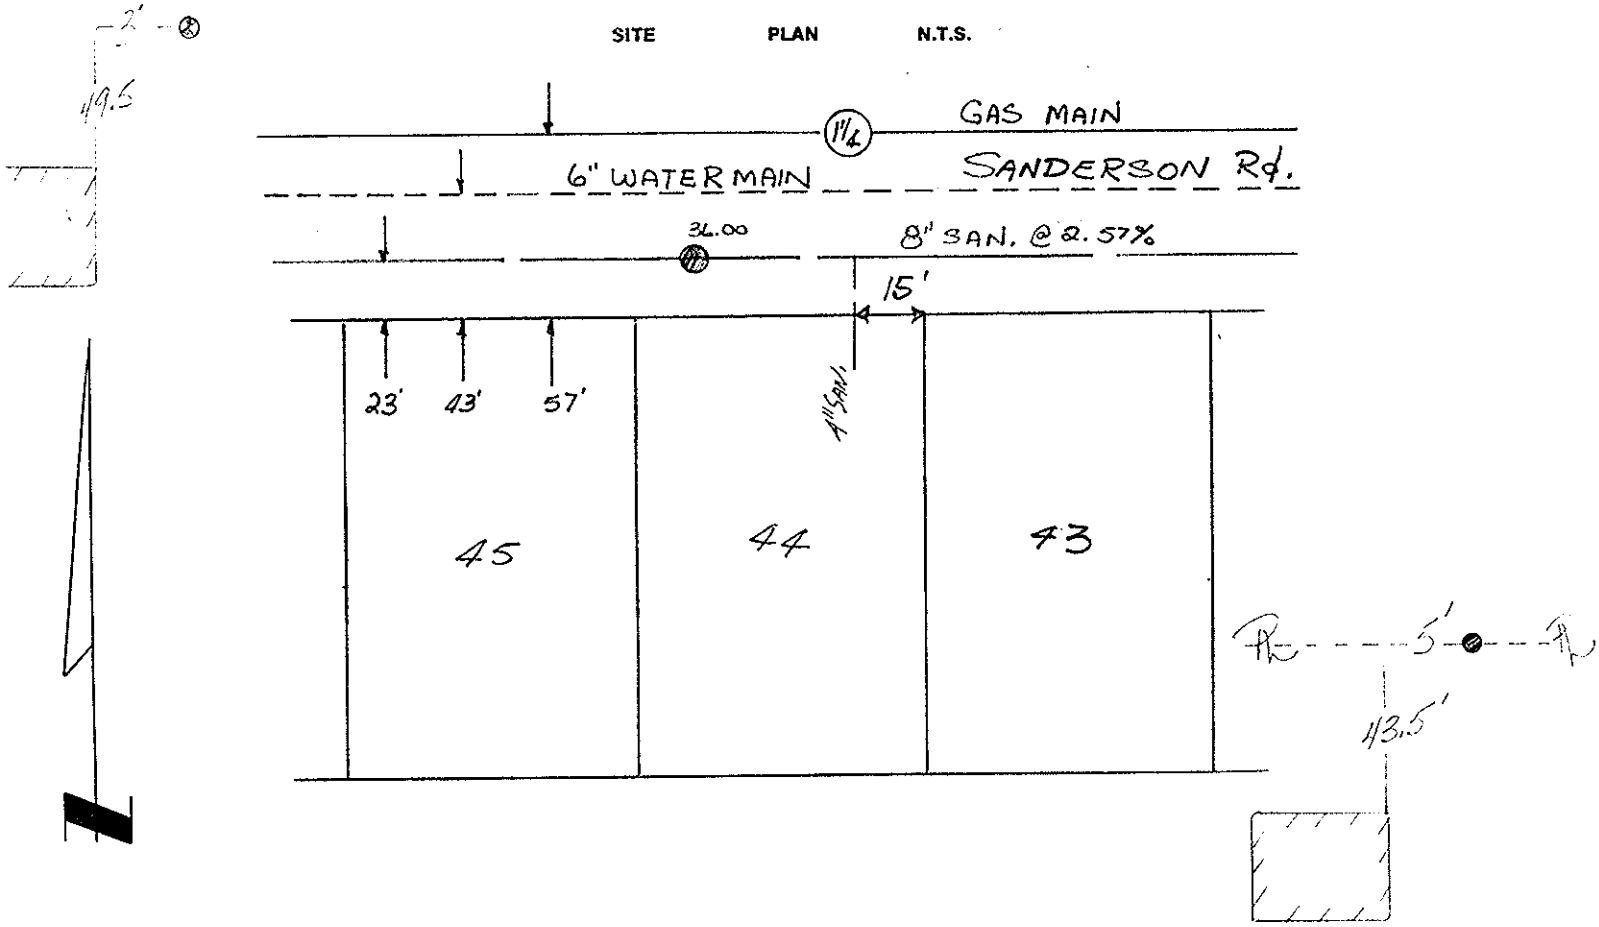
SITE PLAN N.T.S.