City of Prince George
HISTORY SHEET

0126255?4

SHEET NUMBER 6545 **Roll Number**

Legal: LOT'S 24 BLOCK D.L. 2432 PLAN 10676

Address: 9198 N. Kelly Rd.

Sanitary Connection: # 16551 SIZE 100 mm MATERIAL PVC INV. CONNECTED

Water Connection # 16551 SIZE 20mm MATERIAL Cu. METER CONNECTED

Storm Connection: # SIZE MATERIAL INV. CONNECTED

Cash Receipt No's: WATER SANITARY 0554 STORM

CURB FROM PROPERTY LINE PAVEMENT WIDTH

B.C. HYDRO UNDERGROUND CONNECTION

B.C. TELEPHONE UNDERGROUND CONNECTION

INLAND GAS

Information Sheets:

Comments:
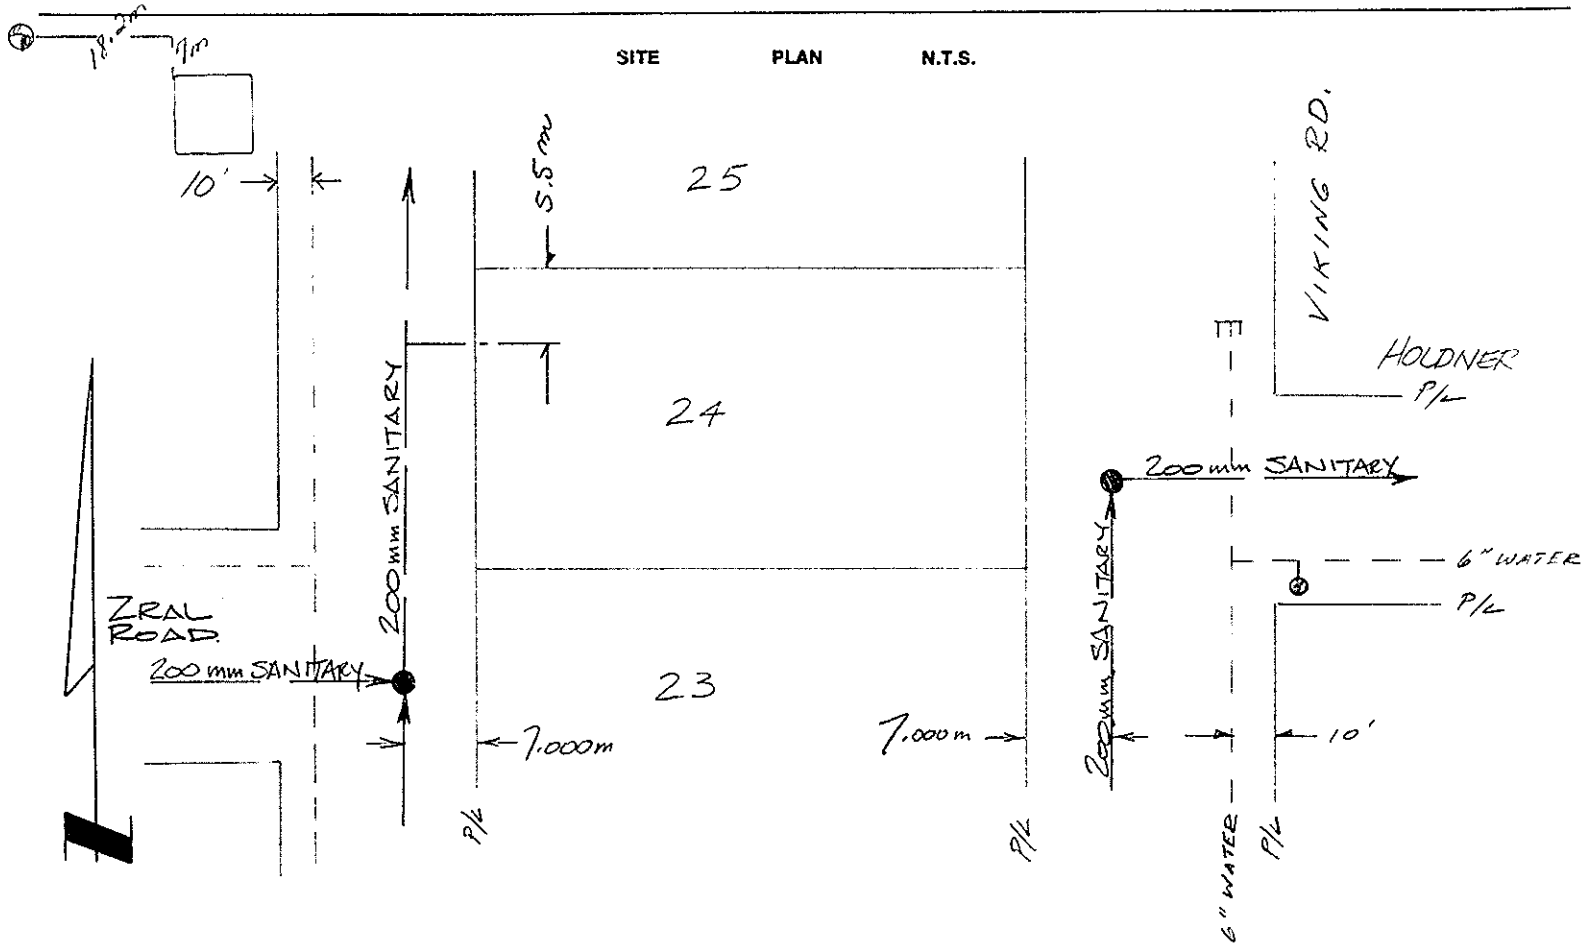
SITE PLAN N.T.S.