City of Prince George
HISTORY SHEET

012629546

SHEET NUMBER 6537 Roll Number

Legal: LOT'S 16 BLOCK D.L. 2432 PLAN 10676

Address: 9413 NEILSON RD.

Sanitary Connection: # SIZE 100mm MATERIAL PVC. INV. CONNECTED

Water Connection # SIZE 20mm MATERIAL Cu METER CONNECTED

Storm Connection: # SIZE MATERIAL INV. CONNECTED

Cash Receipt No's: WATER SANITARY 0562 STORM

CURB FROM PROPERTY LINE PAVEMENT WIDTH

B.C. HYDRO O/H UNDERGROUND CONNECTION

B.C. TELEPHONE O/H UNDERGROUND CONNECTION

INLAND GAS 2.4m FROM FRONT PL

Information Sheets:

Comments:

THE INFORMATION CONTAINED HEREIN IS FOR INTERNAL USE ONLY. NOT TO BE RELIED UPON UNLESS CONFIRMED BY SITE INSPECTION AND/OR INVESTIGATION.
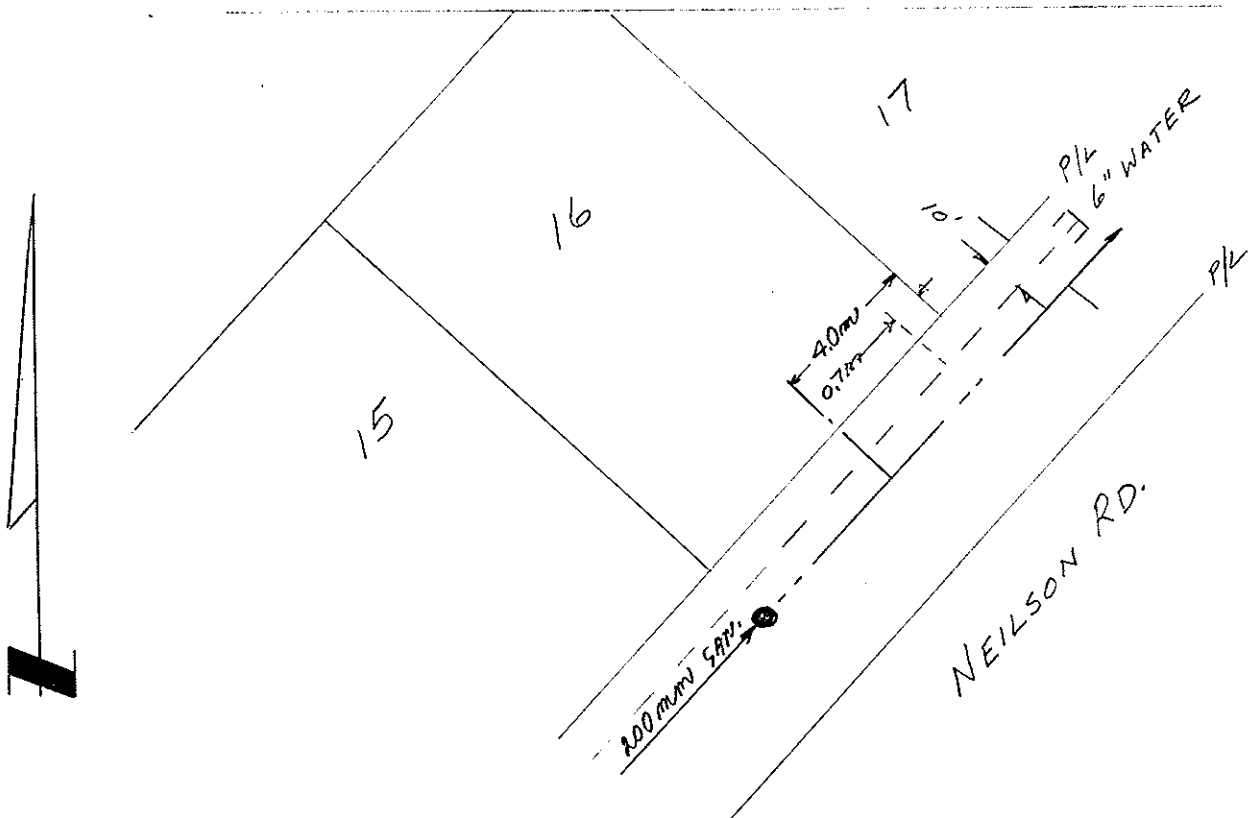
SITE PLAN N.T.S.