City of Prince George
HISTORY SHEET

HH

SHEET NUMBER

Roll Number 012630527

Legal: LOT'S 7 BLOCK D.L. 8182 PLAN 10739

Address: 2758 VANCE RD

Sanitary Connection: # 11615 SIZE 100mm MATERIAL AC INV. CONNECTED

Water Connection # 11615 SIZE 20mm MATERIAL Cu. METER CONNECTED

Storm Connection: # SIZE MATERIAL INV. CONNECTED

Cash Receipt No's: WATER 688 SANITARY 687 STORM

CURB FROM PROPERTY LINE PAVEMENT WIDTH

B.C. HYDRO UNDERGROUND CONNECTION

B.C. TELEPHONE UNDERGROUND CONNECTION

INLAND GAS

Information Sheets:

Comments:
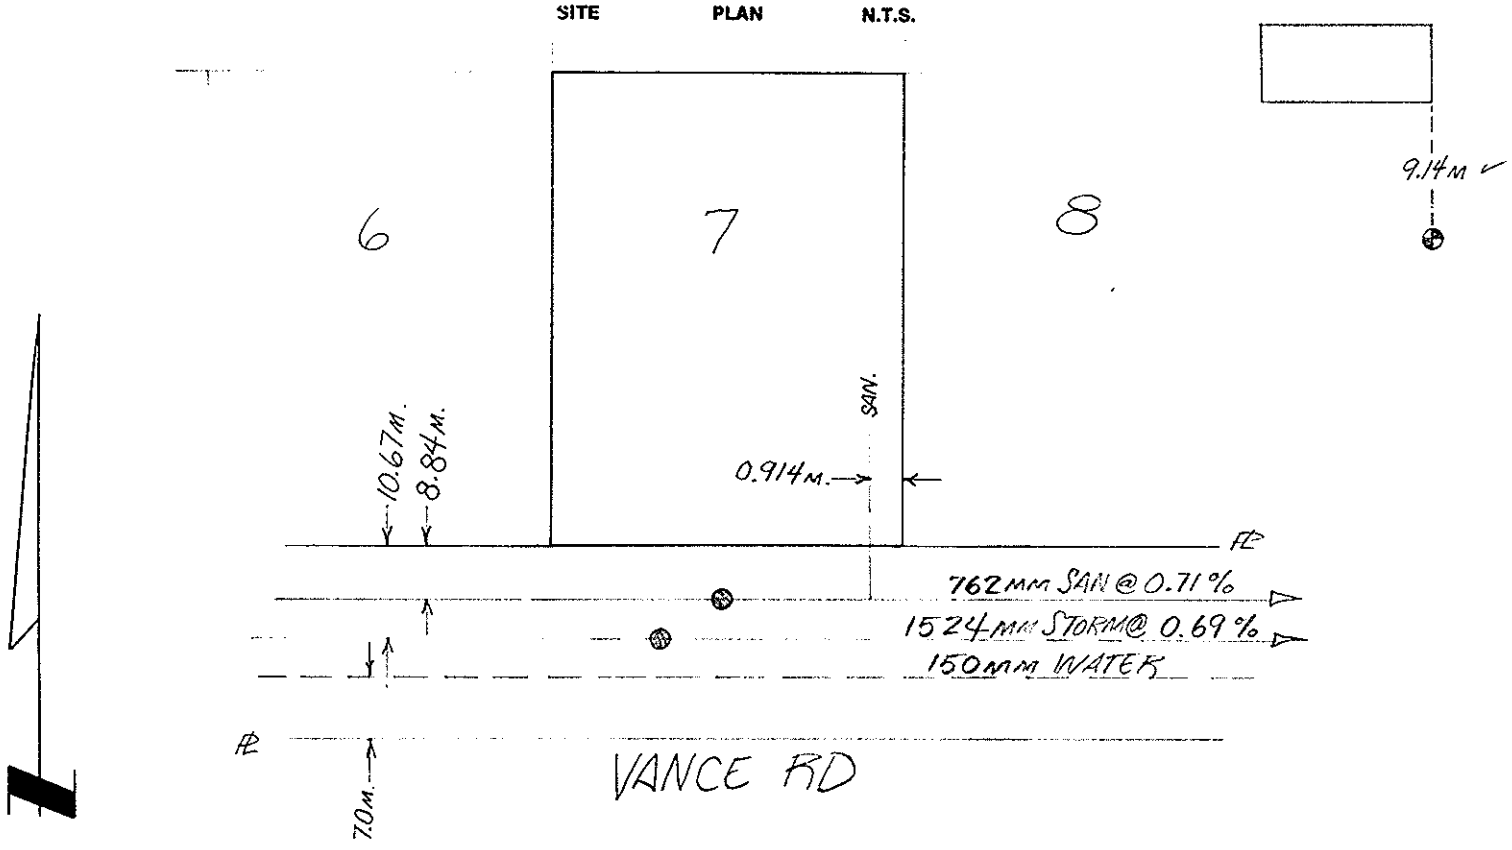
SITE PLAN N.T.S.