City of Prince George
HISTORY SHEET

DIB 032031

SHEET NUMBER **2514** **Roll Number**

Legal: LOT'S 7-8 BLOCK 208 D.L. 343 PLAN 1268

Address: 1653 11th AVENUE

Sanitary Connection: # 1616 SIZE 4" MATERIAL A.C. INV. 1873.35 CONNECTED YES

Water Connection # 2480 SIZE 3/4" MATERIAL COPPER METER CONNECTED YES

Storm Connection: # SIZE MATERIAL INV. CONNECTED

Cash Receipt No's: WATER SANITARY STORM

CURB FROM PROPERTY LINE 16' PAVEMENT WIDTH 34'

B.C. HYDRO O.H. UNDERGROUND CONNECTION

B.C. TELEPHONE O.H. UNDERGROUND CONNECTION

INLAND GAS IN LANE 2" MAIN

Information Sheets:

Comments: BENCH MARK # 53-75 ELEVATION = 1894.26

H.S.N.E CORNER 11th AND PRINCE RUPERT
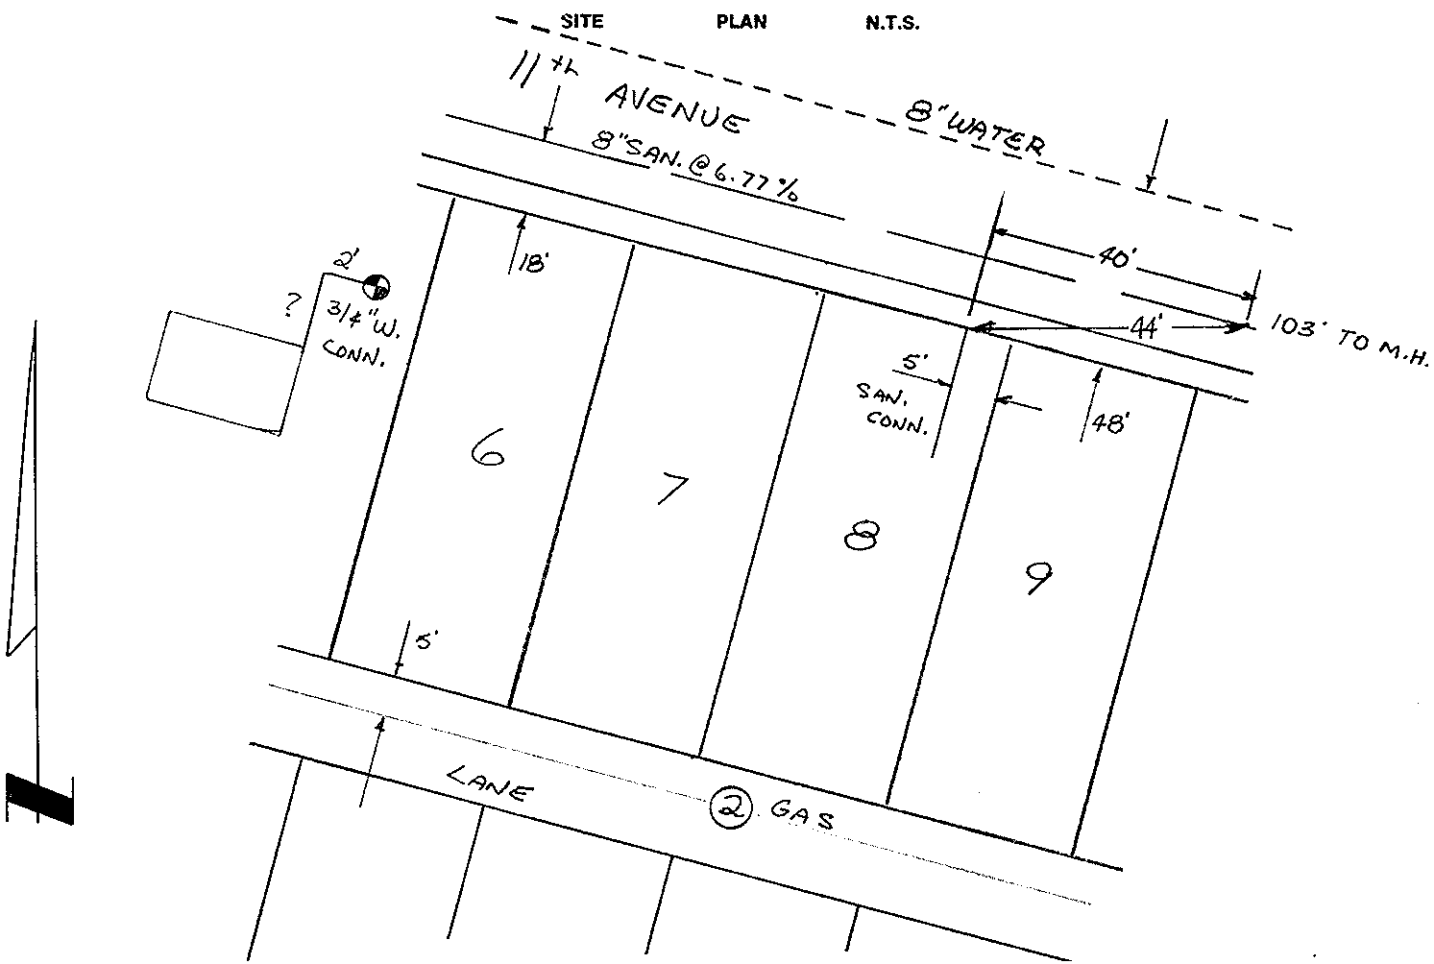
SITE PLAN N.T.S.