City of Prince George
HISTORY SHEET

012639010
012639028

SHEET NUMBER **624** **Roll Number** 1761-000

Legal: LOT'S 9-10 BLOCK 82 D.L. 343 PLAN 1268

Address: WINCENTS HOWARD E, 989 ALWARD ST.
WINCENTS JACQUELINE A PRINCE GEORGE, BC. 989 ALWARD ST.

Sanitary Connection: # 508 SIZE — MATERIAL — INV. 1922.77 CONNECTED YES.

Water Connection # 125 SIZE 1/2" MATERIAL — METER — CONNECTED —

Storm Connection: # SIZE MATERIAL INV. CONNECTED —

Cash Receipt No's: WATER — SANITARY 1282 STORM

CURB FROM PROPERTY LINE 16' PAVEMENT WIDTH 34'

B.C. HYDRO O.H. UNDERGROUND CONNECTION —

B.C. TELEPHONE O.H UNDERGROUND CONNECTION —

INLAND GAS IN LANE 1½" Φ MAIN.

Information Sheets: —
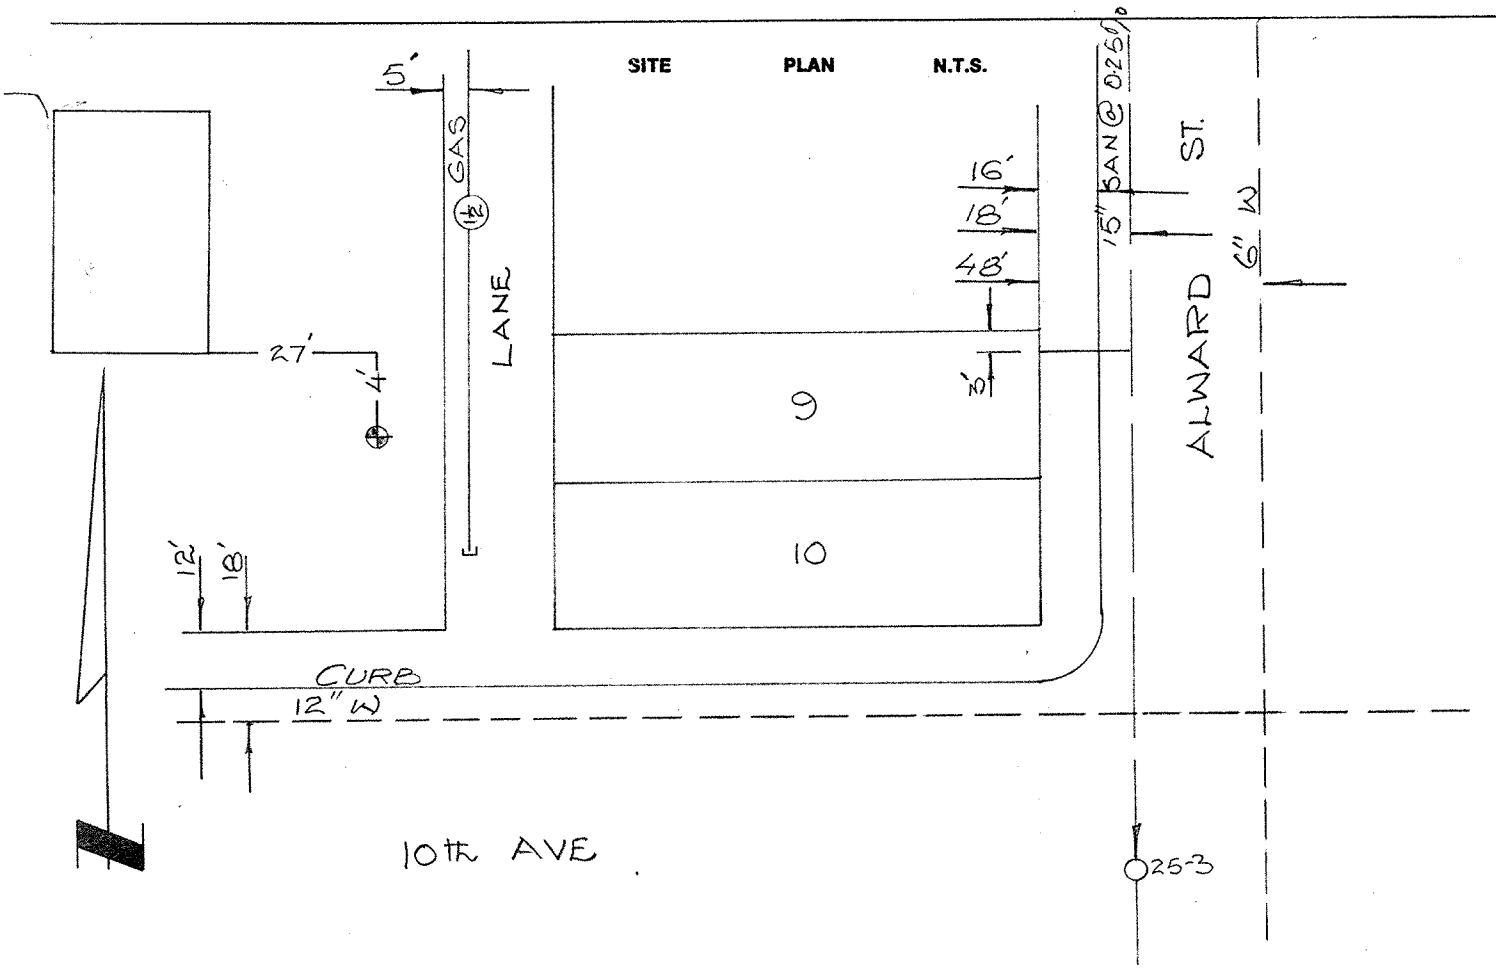
Comments: