City of Prince George
HISTORY SHEET

01269 7443

SHEET NUMBER 1650 **Roll Number**

Legal: LOT'S 16 BLOCK 197 D.L. 343 PLAN 1268

Address: 1454 10th AVE

Sanitary Connection: # 1938 SIZE MATERIAL INV. 1865.50 CONNECTED YES

Water Connection # SIZE MATERIAL METER CONNECTED

Storm Connection: # SIZE MATERIAL INV. CONNECTED

Cash Receipt No's: WATER SANITARY STORM

CURB FROM PROPERTY LINE 10' PAVEMENT WIDTH 46'

B.C. HYDRO O. H. UNDERGROUND CONNECTION

B.C. TELEPHONE O. H. UNDERGROUND CONNECTION

INLAND GAS IN LANE ϕ 3" MAIN

Information Sheets:

Comments: BENCH MARK # 16-77 ELEVATION: 1872.80

L.P. S.W. BOLT SOUTH EAST CORNER 10th & VICTORIA

LEVEL #98 - 10
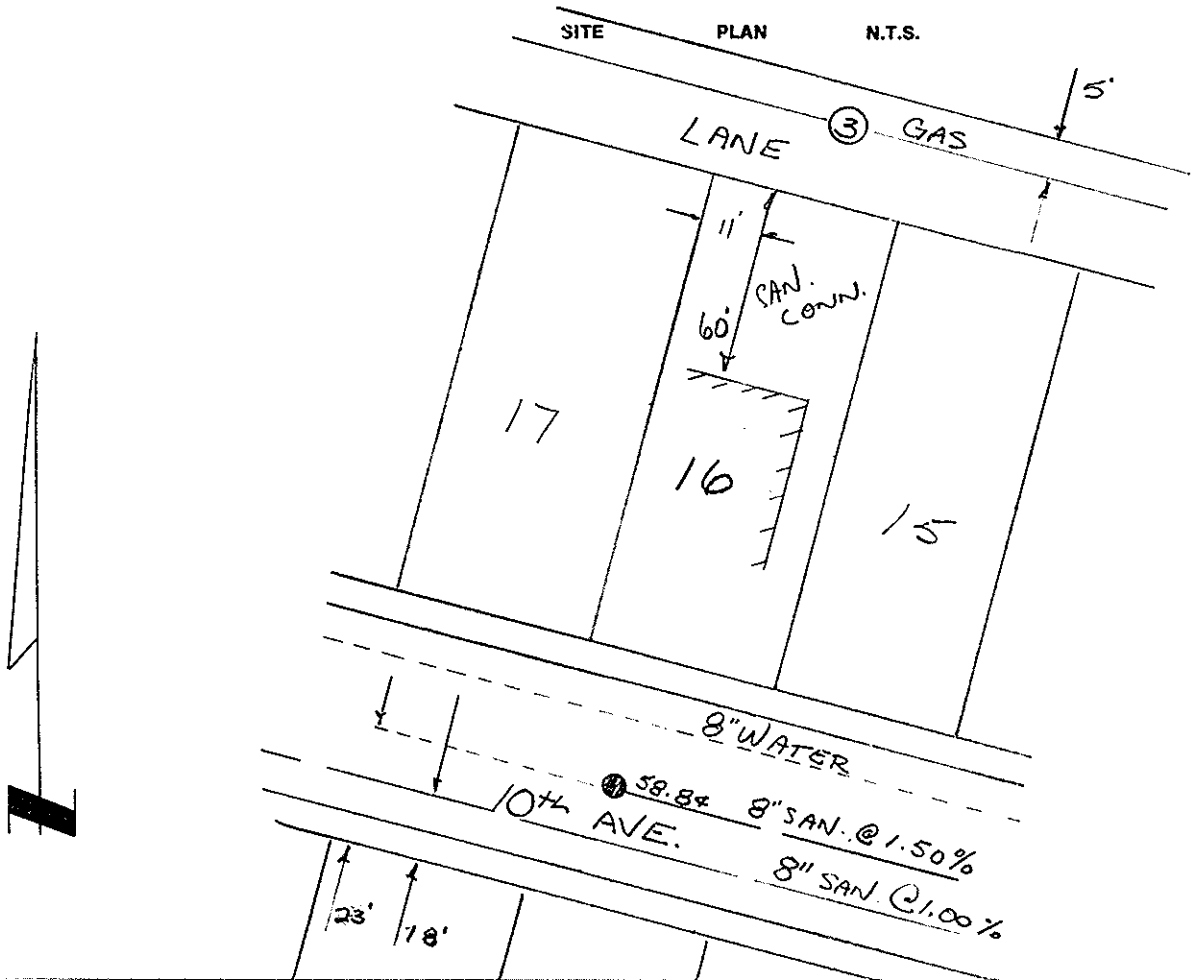
SITE PLAN N.T.S.