City of Prince George
HISTORY SHEET

012767379

SHEET NUMBER **Roll Number**

Legal: LOT'S 16 BLOCK K D.L. 936 PLAN 10005

Address: 1813 GARDEN DRIVE

Sanitary Connection: # 4079 SIZE 100 MM MATERIAL A.C INV. CONNECTED 1965

Water Connection # 3879 SIZE 20mm MATERIAL CU. METER CONNECTED 1964

Storm Connection: # SIZE MATERIAL INV. CONNECTED

Cash Receipt No's: WATER SANITARY STORM

CURB FROM PROPERTY LINE 4.877 m PAVEMENT WIDTH 10.363

B.C. HYDRO U/G UNDERGROUND CONNECTION

B.C. TELEPHONE U/G UNDERGROUND CONNECTION

INLAND GAS AS SHOWN IN LANE

Information Sheets:
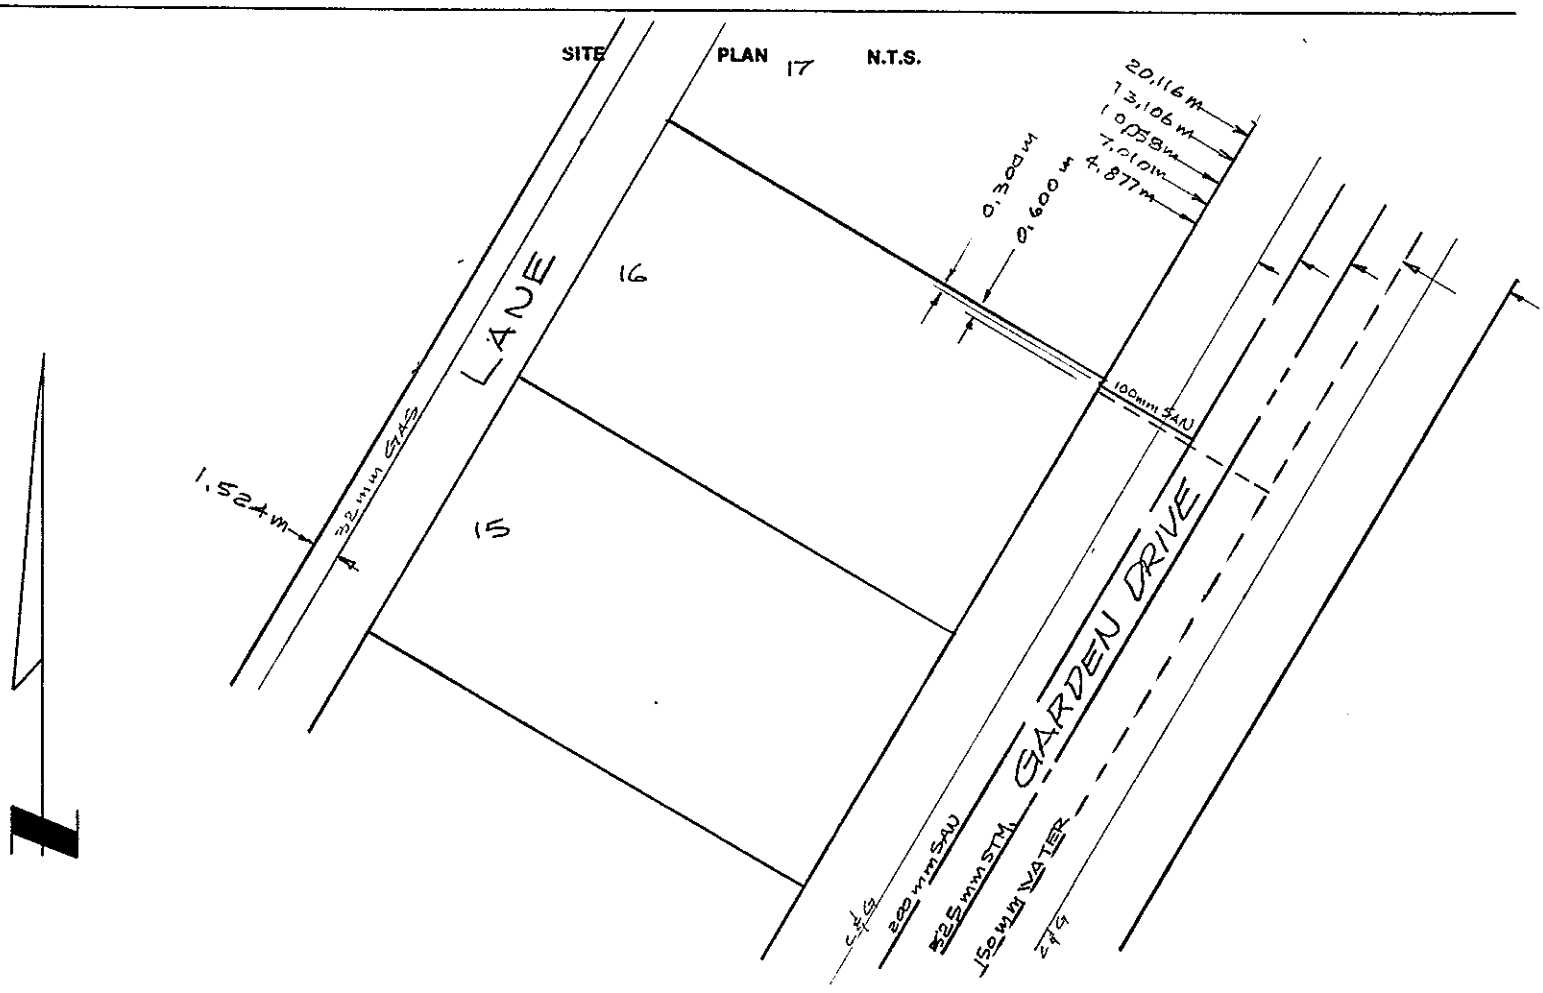
Comments: SERVICE PAID, IN LOT PRICE.