City of Prince George
HISTORY SHEET

SHEET NUMBER | **Roll Number**

Legal: LOT'S 15 BLOCK L D.L. 936 PLAN 10,005

Address: 2834 - 20th Ave.

Sanitary Connection: # 4050 SIZE MATERIAL INV. CONNECTED

Water Connection # 3850 SIZE 20mm MATERIAL Cu. METER CONNECTED

Storm Connection: # SIZE MATERIAL INV. CONNECTED

Cash Receipt No's: WATER SANITARY STORM

CURB FROM PROPERTY LINE 5m PAVEMENT WIDTH

B.C. HYDRO O/H UNDERGROUND CONNECTION

B.C. TELEPHONE O/H UNDERGROUND CONNECTION

INLAND GAS ✓

Information Sheets:

Comments:
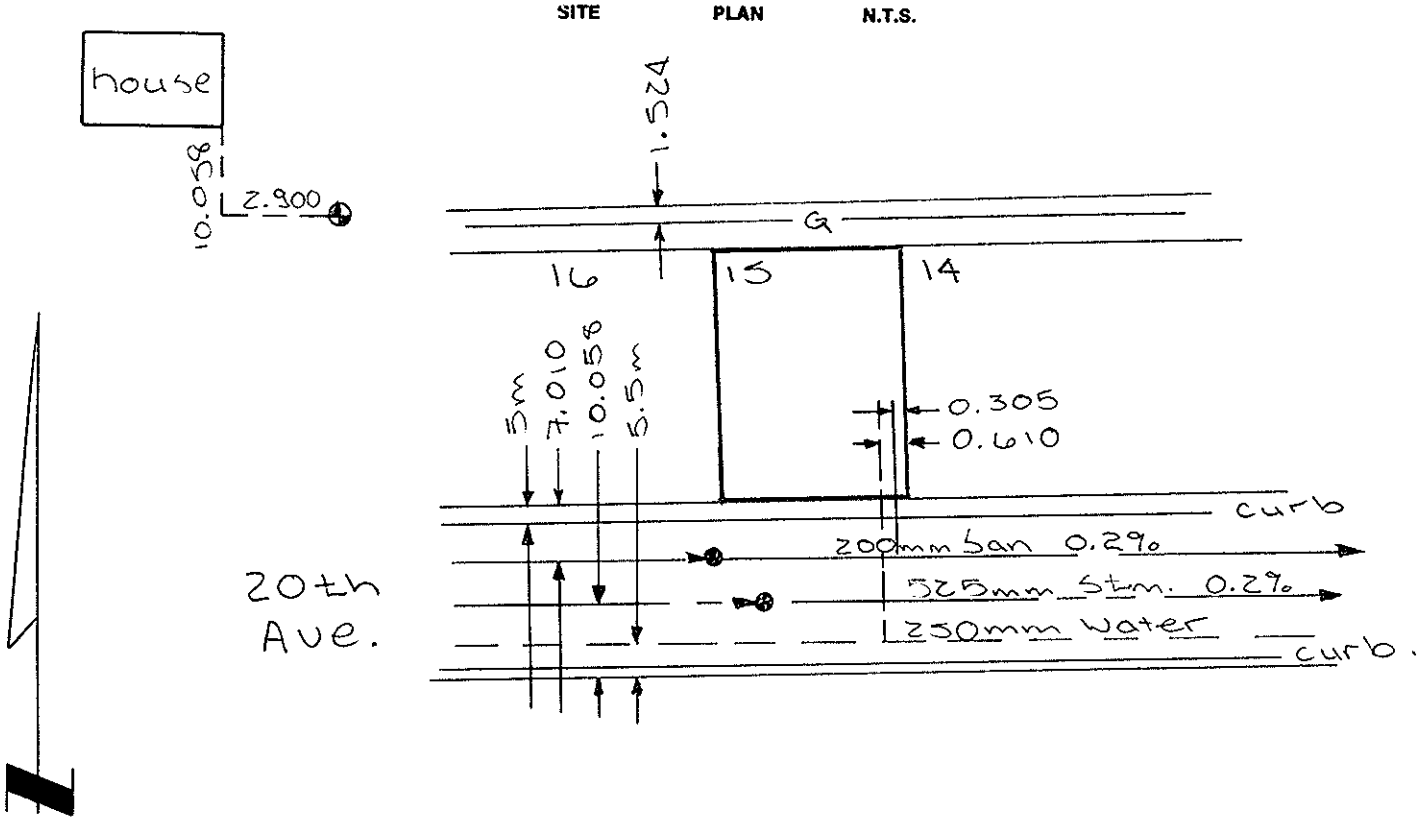
SITE PLAN N.T.S.