City of Prince George
HISTORY SHEET

SHEET NUMBER **1568** **Roll Number**

Legal: LOT'S 3-4-5 BLOCK 189 D.L. 343 PLAN 1263

Address: 1575 8th AVENUE

Sanitary Connection: # 1084 SIZE MATERIAL INV. 1885.79 CONNECTED YES

Water Connection # 2210 SIZE 1/2" MATERIAL Cu METER CONNECTED YES

Storm Connection: # SIZE MATERIAL INV. CONNECTED

Cash Receipt No's: WATER SANITARY STORM

CURB FROM PROPERTY LINE 10' PAVEMENT WIDTH 46'

B.C. HYDRO O.H. UNDERGROUND CONNECTION

B.C. TELEPHONE O.H. UNDERGROUND CONNECTION

INLAND GAS IN LANE ϕ 2" MAIN

Information Sheets: SAN. R.P. 29

Comments: BENCH MARK # 45-73 ELEVATION = 1895.74

#.N. N.E. CORNER 8th AND VANCOUVER

LEVEL BOOK #59-19
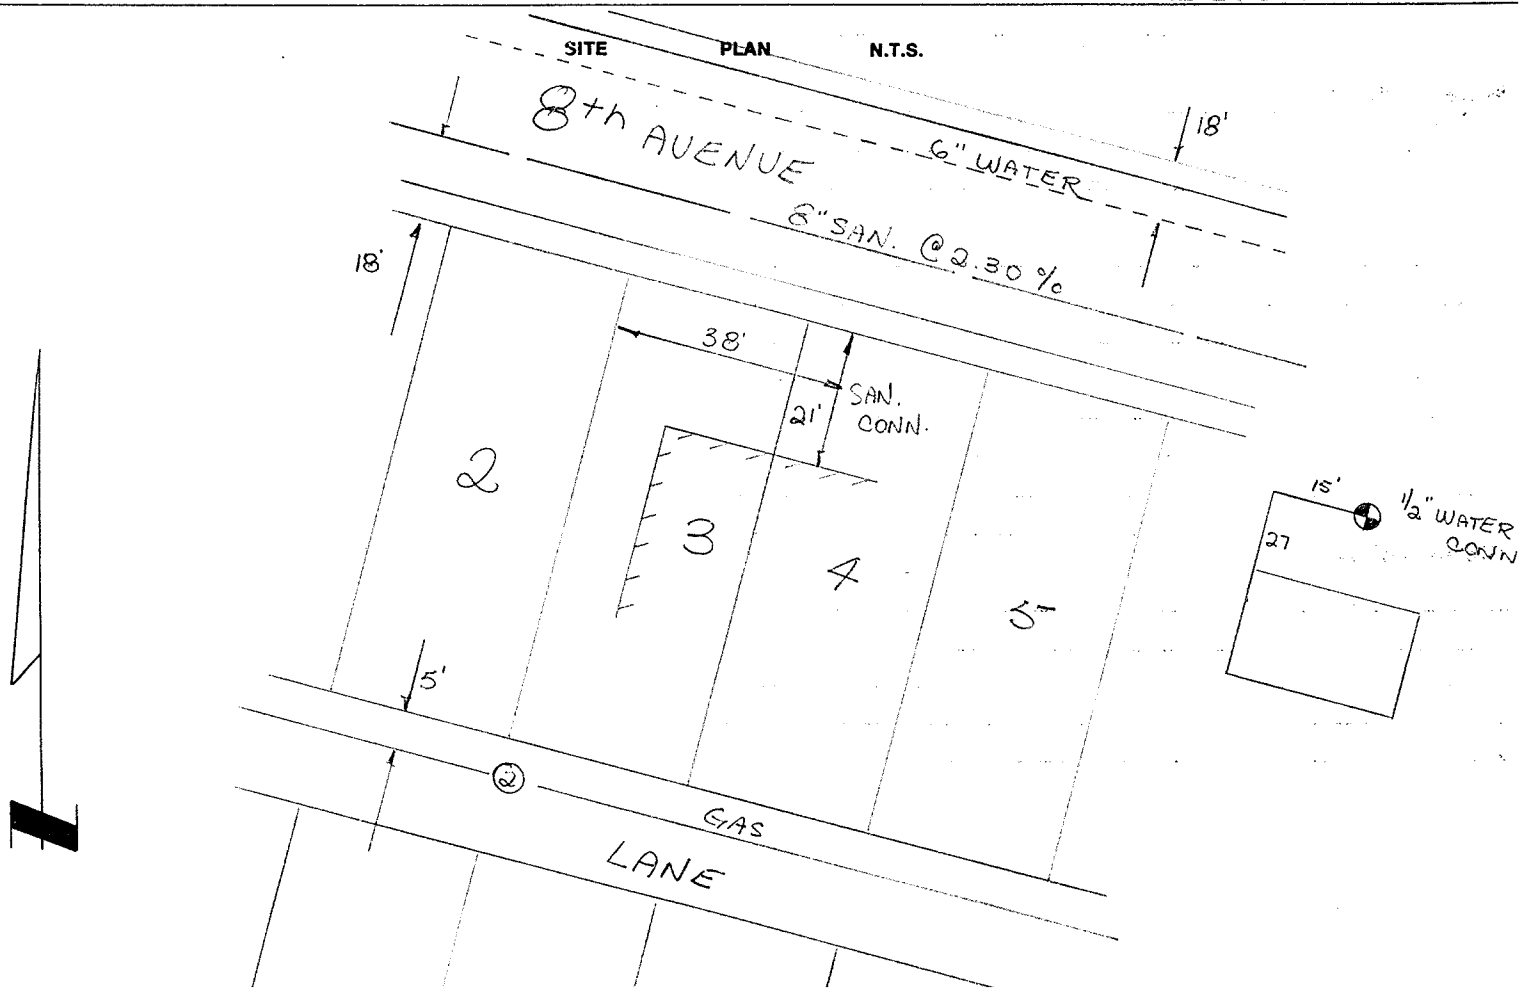
SITE PLAN N.T.S.